THIS PERMIT VOIDS PREVIOUS ISSUED 4-5-00

IREDELL COUNTY HEALTH DEPARTMENT

STATESVILLE 704-878-5305 MOORESVILLE 704-664-5281

IMPROVEMENT PERMIT / AUTHORIZATION TO CONSTRUCT / OPERATION PERMIT / EXISTING SYSTEM INSPECTION

PERMIT# TROUTMAN PIN# (TAX MAP # 3H-C-3) DATE 12-19-01

OWNER OR CONTRACTOR RICK OTTO PHONE: Business (704) 506-8640 Home

ADDRESS 812 TRACE COURT, TROUTMAN, NC 28166

LOCATION US 21 S, TR PERTH RD, TL SPICEWOOD DR, TR NUTMEG LANE, LOT #31 ON RIGHT

SUBDIVISION SPICEWOOD BLOCK / SECTION ____ LOT 31 LOT AREA 0.489 ACRE SITE CLASS PS DESIGN FLOW 360 L.T.A.R. 0.25 GPD/FT

Septic Tank: 1000 Gallons: STB 1007 Date 3-11-02
Pump Tank: ____ Gallons: PT ____ Date ____
Pump Make: ____ Model ____ Serial No. ____
Nitrification Field: No Fields 1 Square Feet 840 to 1440 Linear Feet 240
No Lines SIX Trench Width 24" Max Trench Bottom Depth 36"

☑ New System ☐ Repair System Type: I, II, III, V, VI
System Description: 50% REDUCTION, GRAVITY
Repair System Description: 50% REDUCTION, GRAVITY
Maintenance Agreement Required: ☐ Yes ☑ No
Gravel Depth SAME 6" ☐ Slab ☑ Crawl Space ☐ Basement w/plumbing ☐ Basement wo/plumbing


☑ House/Mod. Home No. Bedrooms 3
☐ Mobile Home No. Bathrooms 2
☐ Business No. Employees ____
☐ Other ____

Water Supply: ☐ Individual ☑ Public ☐ Community


Comments/Conditions: INSTALL 50% REDUCTION SYSTEM USING 54 PPBPS PANELS IN SIX EQUAL LENGTH LINES ON CONTOUR AS SHOWN

Comments/Conditions: SEPTIC TANK WITH RISERS INSTALLED USING "Polylok" FILTER

SCALE: 1" = 40' INITIAL SITE SKETCH

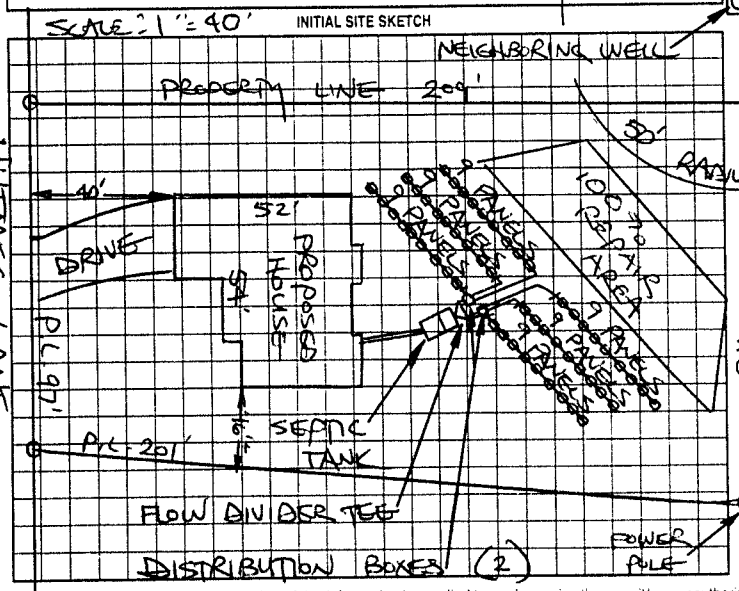

AS BUILT SKETCH

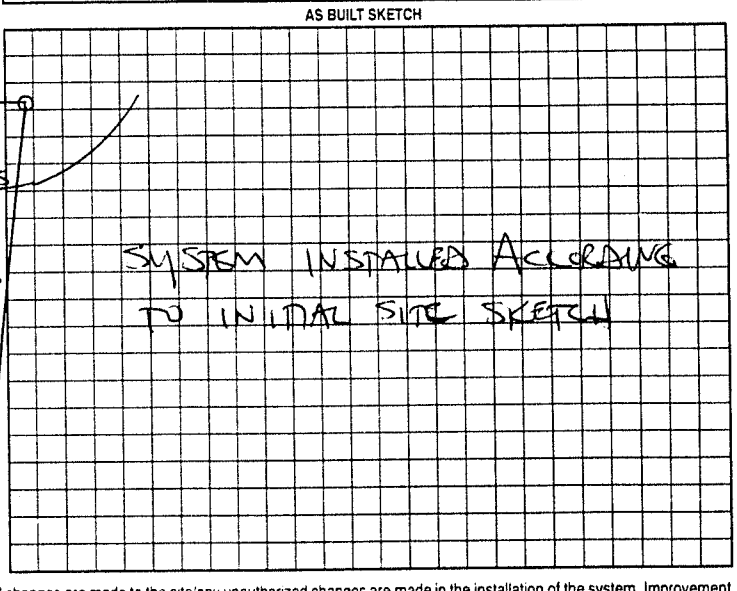

Permit can be suspended or revoked if any false information is supplied toward securing the permit/any unauthorized changes are made to the site/any unauthorized changes are made in the installation of the system. Improvement Permit with plat valid without expiration. Improvement Permit with site plan valid for sixty months. Authorization to Construct is valid for a period equal to that of Improvement Permit – not to exceed sixty months.

Signed: [signature] date 12-19-01 Installed by: WAYNE CLONTZ

Improvement Permit by: STEVE HEDRICK date 12-19-01 Operation Permit by: STEVE HEDRICK date 4-26-02

Authorization to Construct by: STEVE HEDRICK date 12-19-01 Existing System Inspection by: ____ date ____

HEALTH DEPT. COPY: WHITE OWNER COPY (FINAL): YELLOW OWNER COPY (INITIAL): PINK