Rick OTTO (704) 506 8640

IREDELL COUNTY HEALTH DEPARTMENT

STATESVILLE 704-878-5305 MOORESVILLE 704-664-5281

IMPROVEMENT PERMIT / AUTHORIZATION TO CONSTRUCT / OPERATION PERMIT / EXISTING SYSTEM INSPECTION

PERMIT# -2- TROUTMAN PIN# 3H-C-3 DATE 4/5/00

OWNER OR CONTRACTOR LARRY DAVIS PHONE: Business 664-9407 Home

ADDRESS 450 OAK TREE RD MOORESVILLE

LOCATION 21S - TR PERTH RD - TL SPICEWOOD - TR NUTMEG - ON RT

SUBDIVISION SPICEWOOD BLOCK / SECTION LOT 31 LOT AREA .489AC SITE CLASS PS DESIGN FLOW 360GPD L.T.A.R. .25gal/ft²

Septic Tank: 1000 Gallons; STB Date

Pump Tank: 1000 Gallons; PT Date

Pump Make: Model Serial No.

Nitrification Field: No Fields 1 Square Feet 1125 Linear Feet 375

No Lines 5@75' Trench Width 36" Max Trench Bottom Depth 26" Gravel Depth N/A

☒ New System ☐ Repair System Type: I, II, (III), IV, V, VI

System Description: ~~RED~~ INNOVATIVE GRAVITY

Repair System Description: SAME

Maintenance Agreement Required: ☐ Yes ☒ No

☒ House/Mod. Home No. Bedrooms 3

☐ Mobile Home No. Bathrooms 2

☐ Business No. Employees

☐ Other


☐ Slab ☑ Crawl Space ☐ Basement w/plumbing ☐ Basement wo/plumbing

Water Supply: ☒ Individual ☒ ~~Public~~ ☐ Community

Comments:/Conditions: 1) KEEP SYSTEM AND REPAIR 50' FROM NEIGHBOR'S WELL.

Comments:/Conditions:

INITIAL SITE SKETCH 1"=50'

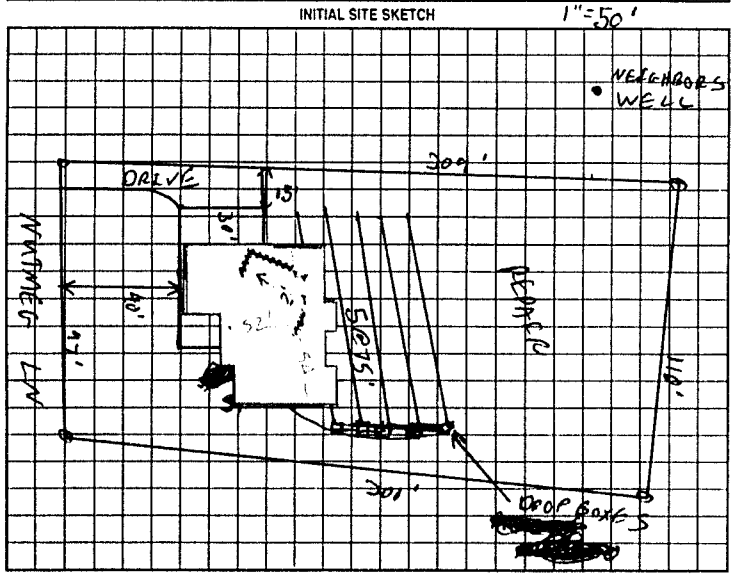

AS BUILT SKETCH

Permit can be suspended or revoked if any false information is supplied toward securing the permit/any unauthorized changes are made to the site/any unauthorized changes are made in the installation of the system. Improvement Permit with plat valid without expiration. Improvement Permit with site plan valid for sixty months. Authorization to Construct is valid for a period equal to that of Improvement Permit - not to exceed sixty months.

Signed: Larry Davis date 4/5/00

Improvement Permit by: C. [illegible] RS date 4/5/00

Authorization to Construct by: date

Installed by:

Operation Permit by: date

Existing System Inspection by: date

HEALTH DEPT COPY WHITE OWNER COPY (FINAL) YELLOW OWNER COPY (INITIAL) PINK