IREDELL COUNTY HEALTH DEPARTMENT

Statesville Phone TR 3-7271 — Mooresville Phone NO 3-1271

PERMIT TO INSTALL SEPTIC TANK

Permit NO. _____ Permit Date Oct 1960

Owner Keith Kelly Address Troutman, N.C.

Installed By Normans Vault Co. Address Troutman, N.C.


Location of Property Neil and Clontz New Developement on Perth Church Road

| Tank | | Capacity | | Length of Lines | | Fixtures | |
|---|---|---|---|---|---|---|---|
| Block | (✓) | 800 | ( ) | 150' | ( ) | No. of Baths | ( ) |
| Precast | ( ) | 900 | ( ) | 175' | ( ) | Dishwasher | ( ) |
| | | 1000 | (✓) | 200' | ( ) | Garbage Grdr. | ( ) |
| | | 1100 | ( ) | 225' | (✓) | Auto-Washer | ( ) |
| | | 1200 | ( ) | 250' | ( ) | Other _____ | |
| | | Other _____ | | Other _____ | | | |

NOTIFY HEALTH DEPARTMENT AT LEAST EIGHT HOURS BEFORE TANK IS TO BE INSPECTED.

Final Inspection Oct 1960 Approved (✓) Disapproved ( )

Remarks _____

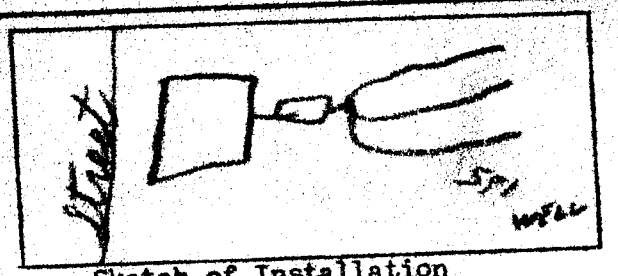


Sketch of Installation

Self approved
Oct.
Rut.

Sanitarian