IREDELL COUNTY HEALTH DEPARTMENT

STATESVILLE 704-878-5305 MOORESVILLE 704-664-5281

IMPROVEMENT PERMIT / AUTHORIZATION TO CONSTRUCT / OPERATION PERMIT / EXISTING SYSTEM INSPECTION

PERMIT# REPAIR PIN# 4730-78-3379 DATE 4-5-06

OWNER OR CONTRACTOR RILEY K. SHERRILL PHONE: Business Home 704-528-5370

ADDRESS 138 SPICEWOOD CIRCLE, TROUTMAN, NC 28166

LOCATION US 21 S, TR PERTH RD, TL SPICEWOOD CIRCLE, ON RIGHT AT NUTMEG LANE

SUBDIVISION BLOCK / SECTION LOT LOT AREA UNIMPROVED SITE CLASS. PS DESIGN FLOW 240 L.T.A.R. 0.30 GPD/FT2

Septic Tank: 1000 Gallons; STB 1012 Date 8-28-05

Pump Tank: Gallons; PT Date

Pump Make: Model Serial No.

Nitrification Field: No Fields Square Feet 576 Linear Feet 144'

No Lines THREE Trench Width 36" Max Trench Bottom Depth 36" Gravel Depth N/A

☐ New System ☑ Repair System Type: I, II, III, IV, V, VI

System Description:

Repair System Description: 25% REDUCTION, GRAVITY

Maintenance Agreement Required: ☐ Yes ☑ No

☑ House/Mod. Home No. Bedrooms 2

☐ Mobile Home No. Bathrooms

☐ Business No. Employees

☐ Other

☐ Slab ☑ Crawl Space ☐ Basement w/plumbing ☐ Basement wo/plumbing


Water Supply: ☑ Individual ☐ Public ☐ Community

WELL

Comments:/Conditions: INSTALL 25% REDUCTION SYSTEM ON CONTOUR AS FLAGGED ON SITE. USE DROP BOXES FOR SERIAL DISTRIBUTION

Comments:/Conditions: SEPTIC TANK WITH MARKER INSTALLED USING "TUFFTE" RISER

INITIAL SITE SKETCH

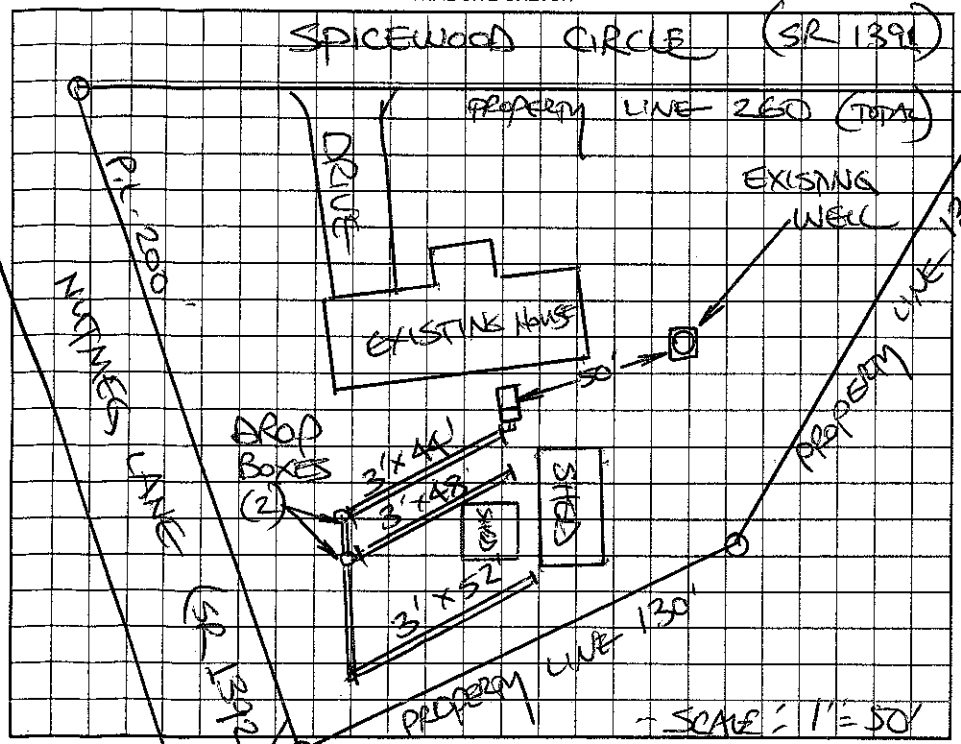

AS BUILT SKETCH

SYSTEM REPAIRED ACCORDING TO INITIAL SITE SKETCH

Permit can be suspended or revoked if any false information is supplied toward securing the permit/any unauthorized changes are made to the site/any unauthorized changes are made in the installation of the system. Improvement Permit with plat valid without expiration. Improvement Permit with site plan valid for sixty months. Authorization to Construct is valid for a period equal to that of Improvement Permit – not to exceed sixty months.

Signed: Riley K. Sherrill date 4-5-06 Installed by: DAVID YOUNTZ

Improvement Permit by: STEVE HEDRICK date 4-5-06 Operation Permit by: STEVE HEDRICK date 4-10-06

Authorization to Construct by: STEVE HEDRICK date 4-5-06 Existing System Inspection by: date

HEALTH DEPT. COPY: WHITE OWNER COPY (FINAL): YELLOW OWNER COPY (INITIAL): PINK