IREDELL COUNTY HEALTH DEPARTMENT

*THIS PERMIT VOIDS PREVIOUSLY ISSUED PERMIT ON 05-28-99

STATESVILLE 704-878-5305 MOORESVILLE 704-664-5281

IMPROVEMENT PERMIT / AUTHORIZATION TO CONSTRUCT / OPERATION PERMIT / EXISTING SYSTEM INSPECTION

PERMIT# TROUTMAN PIN# [redacted] 4730-78-3663 DATE 10/23/02

OWNER OR CONTRACTOR BERNHAROT COMMUNITIES PHONE: Business 704-506-8640 Home

ADDRESS 812 TRACE CT TROUTMAN, NC 28166

LOCATION 21 SOUTH, (R) PERTH RD, (L) SPIZEWOOD CR, 6th LOT ON LEFT (139 SPIZEWOOD CR)

SUBDIVISION SPIZEWOOD BLOCK / SECTION LOT [redacted] LOT AREA 0.52 ACRES SITE CLASS. PS DESIGN FLOW 360 GPD L.T.A.R. 0.30

Septic Tank: 1,000 Gallons; STB 1007 Date 11/08/02
Pump Tank: 1,000 Gallons; PT 274 Date 11/01/02
Pump Make: ZOELLER Model N-152A Serial No. 115V/1HP
Nitrification Field: No Fields 1 Square Feet EQ to 1,200 Linear Feet 300
No Lines 5@60' Trench Width 36" Max Trench Bottom Depth 36"

[X] New System [ ] Repair System Type: I, II, (III), IV, V, VI
System Description: 25% REDUCTION, PUMP
Repair System Description: 50% REDUCTION, LOW PRESSURE
Maintenance Agreement Required: [ ] Yes [X] No

[X] House/Mod. Home No. Bedrooms 3
[ ] Mobile Home No. Bathrooms 2
[ ] Business No. Employees
[ ] Other


Gravel Depth N/A [X] Slab [ ] Crawl Space [ ] Basement w/plumbing [ ] Basement wo/plumbing

Water Supply: [ ] Individual [X] Public [ ] Community

Comments/Conditions: (1) MAINTAIN ALL SETBACKS (2) INSTALL LINES ON CONTOUR (3) CALL PRIOR TO INSTALLATION FOR PUMP & PRESSURE MANIFOLD INFO.

Comments/Conditions: -S.T. INSTALLED - SIMTECH FILTER & TANK MARKER

INITIAL SITE SKETCH

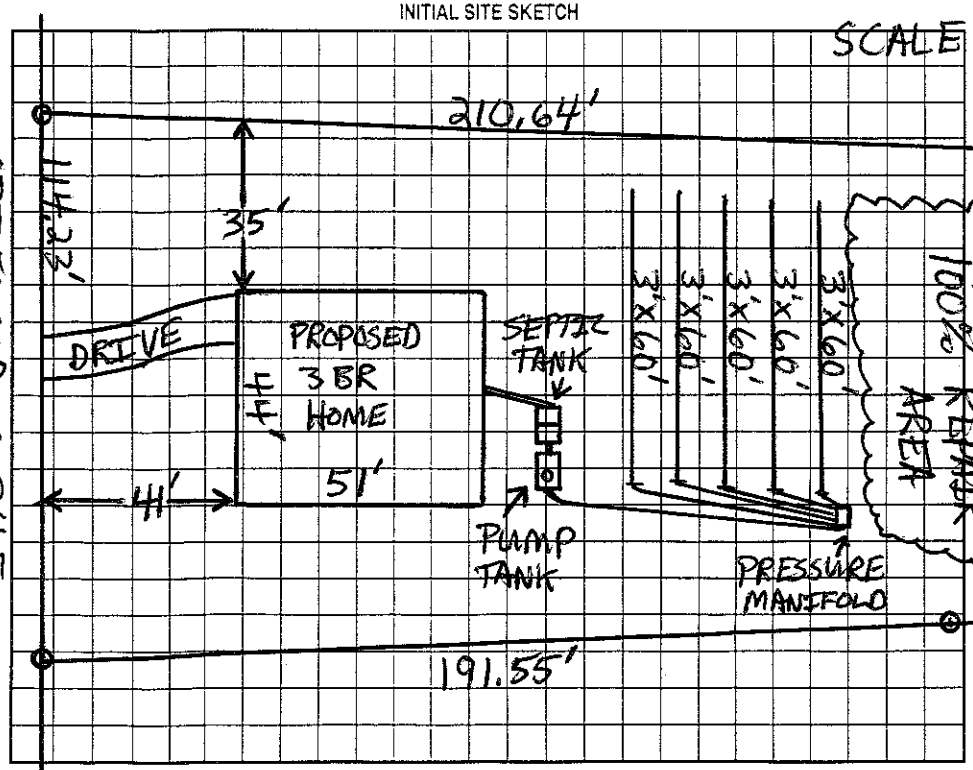


AS BUILT SKETCH

*SYSTEM INSTALLED AS SHOWN IN INITIAL SITE SKETCH.

☆ONLY CHANGE: PRESSURE MANIFOLD WAS MOVED WITHOUT PRIOR H. DEPT APPROVAL.

*NOT TO SCALE.

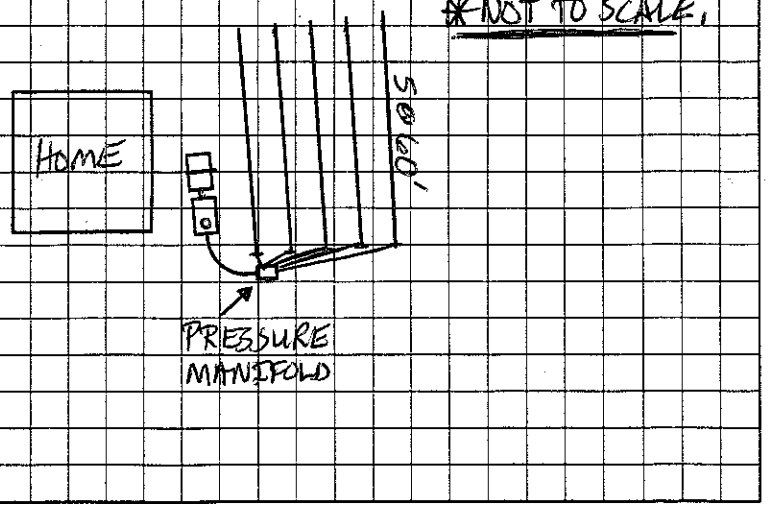

Permit can be suspended or revoked if any false information is supplied toward securing the permit/any unauthorized changes are made to the site/any unauthorized changes are made in the installation of the system. Improvement Permit with plat valid without expiration. Improvement Permit with site plan valid for sixty months. Authorization to Construct is valid for a period equal to that of Improvement Permit – not to exceed sixty months.

Signed: RBOYLE date 11-27-02 Installed by: WAYNE CLONTZ 03/13/03

Improvement Permit by: Patrick Mitchell date 10/23/02 Operation Permit by: Patrick Mitchell date 04/08/03

Authorization to Construct by: Patrick Mitchell date 10/23/02 Existing System Inspection by: date

HEALTH DEPT. COPY: WHITE OWNER COPY (FINAL): YELLOW OWNER COPY (INITIAL): PINK