IREDELL COUNTY HEALTH DEPARTMENT

Statesville Office (704) 878-5305 Mooresville Office (704) 660-3625

IMPROVEMENT PERMIT / AUTHORIZATION TO CONSTRUCT / OPERATION PERMIT / EXISTING SYSTEM

PERMIT # 203317

APPLICANT: Kent Shaw

PIN # 4730788663

SITE ADDRESS: 139 Spicewood Cir Troutman NC

APPLICANT ADDRESS: P.O. Box 1061 Troutman NC

SITE DIRECTIONS: 1155 (R) on Perth (L) Spicewood 6th lot on left

PHONE: 704-902-0085 ALT. PHONE: N/A

SUBDIVISION: Spicewood

SECTION: N/A LOT # N/A LOT AREA: .52ac

DESIGN FLOW: 360 L.T.A.R.: EX

Septic Tank	EX (gal)	STB	Date		
Pump Tank	(gal)	PT	Date		
Pump Make		Model	Serial #		
# Nitrification Fields	1	# Lines	EX	Linear Ft:	EX
Trench Width	EX	Max. Trench Bottom Depth	EX	Gravel Depth	EX

☐ New System ☐ Repair ☐ Expansion System Type: I II (III) IV V VI

System Description: Existing

Repair System Description:

Maintenance Agreement Required: ☐ YES ☒ NO ☐ GRAVITY ☒ PRESSURE

☒ Residence ☐ Business ☐ Other ☐ Slab ☐ Basement w/plumbing


No. Bedrooms 3 No. Persons 6 No. Employees ____ ☒ Crawl Space

Water Supply: ☐ Private ☒ Public ☐ Community


☐ Basement w/o plumbing

Comments / Conditions: All building foundations must be 35' from any part of STS and 25' from any well!

INITIAL SITE SKETCH

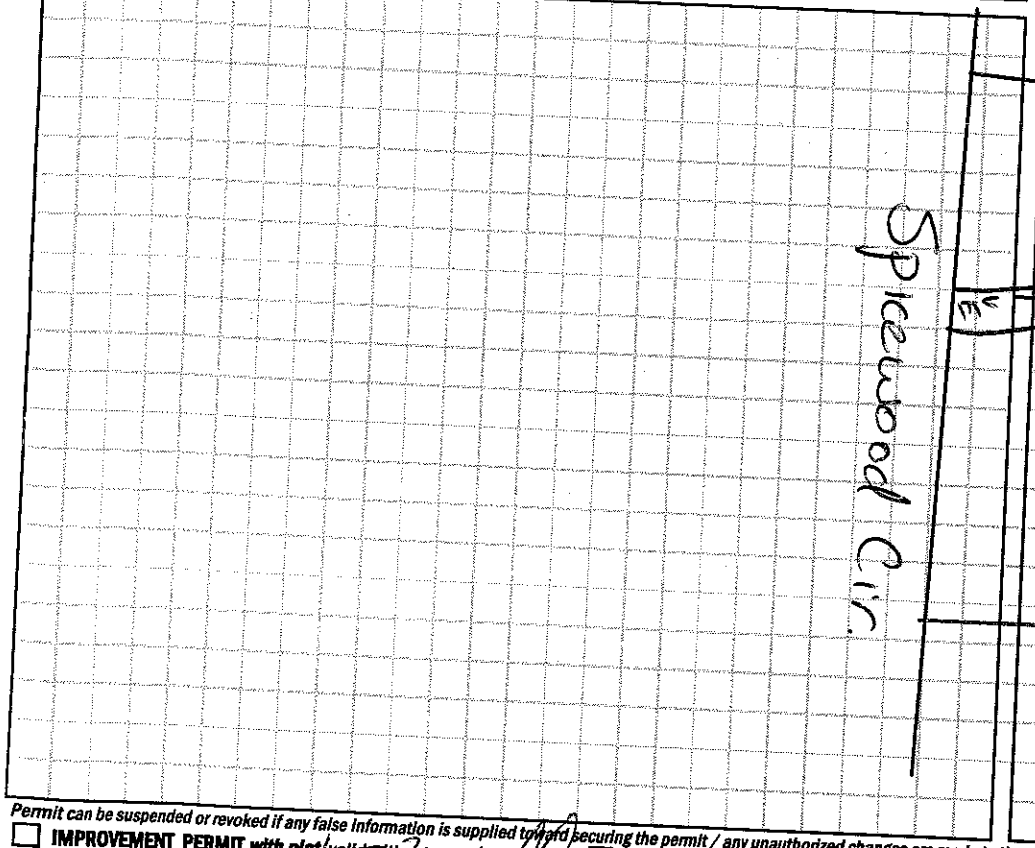

AS BUILT SKETCH

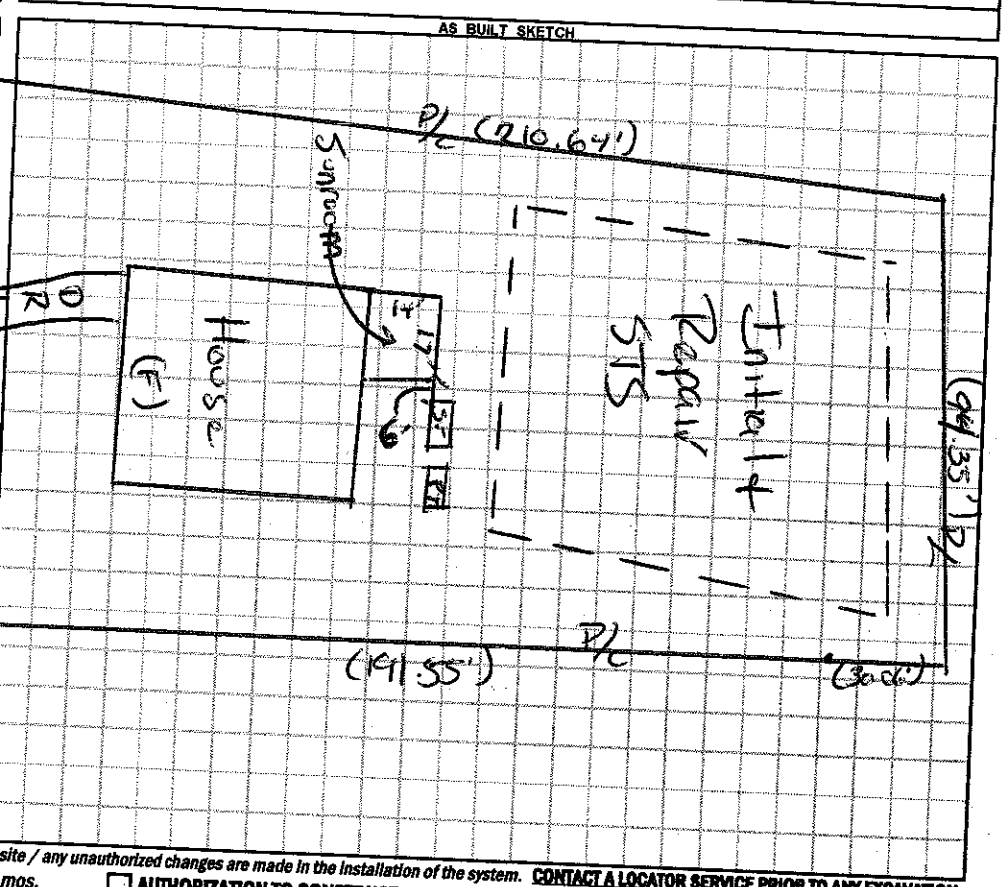

Permit can be suspended or revoked if any false information is supplied toward securing the permit / any unauthorized changes are made to the site / any unauthorized changes are made in the installation of the system. **CONTACT A LOCATOR SERVICE PRIOR TO ANY EXCAVATION**

☐ **IMPROVEMENT PERMIT** *with plat valid without expiration* ☐ **IMPROVEMENT PERMIT** *with site plan valid for 60 mos.* ☐ **AUTHORIZATION TO CONSTRUCT** *valid for period equal to IMPROVEMENT PERMIT--not to exceed 60 mo.*

Owner / Applicant Signature: [signature] Date: 5-27-14

IMPROVEMENT PERMIT by: Date:

AUTHORIZATION TO CONSTRUCT by: Date:

Installed by:

OPERATION PERMIT by: Date:

Existing System Inspected by: [signature] Date: 05/22/14

Health Dept. Copy - WHITE Applicant (Final Approval) - YELLOW Applicant (Conditional Approval) - PINK