*THIS PERMIT VOIDS PREVIOUSLY ISSUED PERMIT ON 05-289

IREDELL COUNTY HEALTH DEPARTMENT

STATESVILLE 704-878-5305 MOORESVILLE 704-664-5281

IMPROVEMENT PERMIT / AUTHORIZATION TO CONSTRUCT / OPERATION PERMIT / EXISTING SYSTEM INSPECTION

PERMIT# TROUTMAN PIN# 4730-78-3663 DATE 10/23/02

OWNER OR CONTRACTOR BERNHARDT COMMUNITIES PHONE: Business 704-506-8640 Home

ADDRESS 812 TRACE CT TROUTMAN, NC 28166

LOCATION 21 SOUTH, (R) PERTH RD, (L) SPICEWOOD CR, 6th LOT ON LEFT (139 SPICEWOOD CR)

SUBDIVISION SPICEWOOD BLOCK / SECTION LOT LOT AREA 0.52 ACRES SITE CLASS. PS DESIGN FLOW 360 GPD L.T.A.R. 0.30

Septic Tank: 1,000 Gallons; STB Date

Pump Tank: 1,000 Gallons; PT Date

Pump Make: Model Serial No.

Nitrification Field: No Fields 1 Square Feet EQ to 1,200 Linear Feet 300

No Lines 5 @ 60' Trench Width 36" Max Trench Bottom Depth 36"

X New System ☐ Repair System Type: I, II, (III) IV, V, VI

System Description: 25% REDUCTION, PUMP

Repair System Description: 50% REDUCTION, LOW PRESSURE

Maintenance Agreement Required: ☐ Yes X No

X House/Mod. Home No. Bedrooms 3

☐ Mobile Home No. Bathrooms 2

☐ Business No. Employees

☐ Other

X Slab ☐ Crawl Space ☐ Basement w/plumbing ☐ Basement wo/plumbing


Water Supply: ☐ Individual X Public ☐ Community

Comments/Conditions: (1) MAINTAIN ALL SETBACKS (2) INSTALL LINES ON CONTOUR (3) CALL PRIOR TO INSTALLATION FOR PUMP & PRESSURE MANIFOLD INFO.

Comments:/Conditions:

INITIAL SITE SKETCH

SCALE 1" = 40'

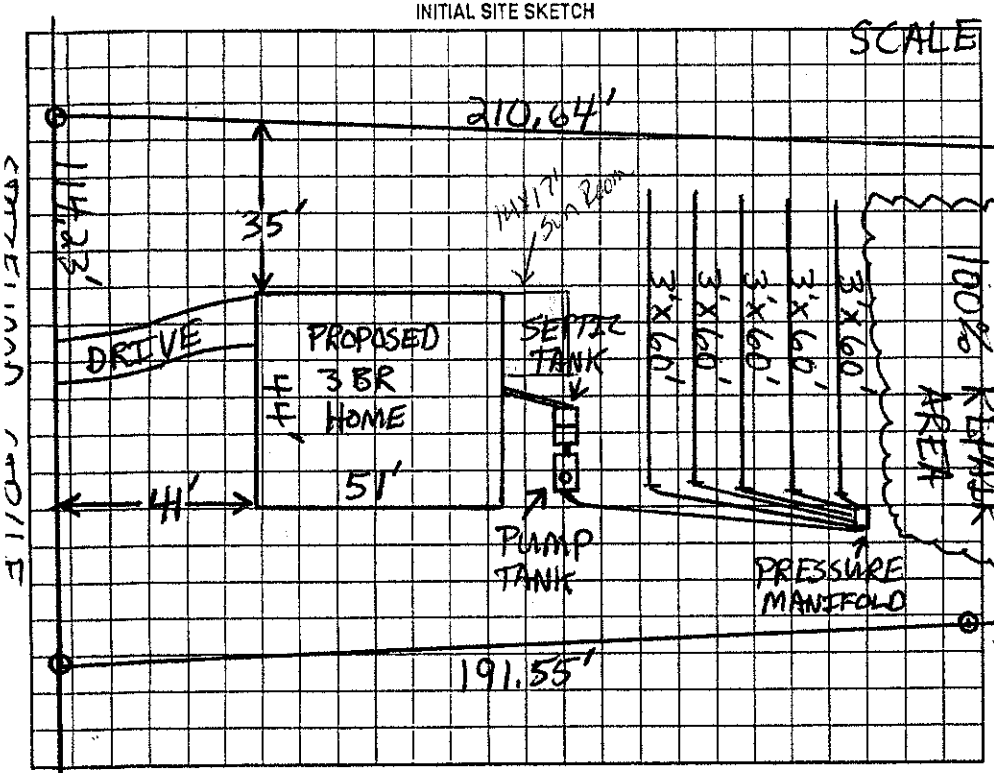

AS BUILT SKETCH

Permit can be suspended or revoked if any false information is supplied toward securing the permit/any unauthorized changes are made to the site/any unauthorized changes are made in the installation of the system. Improvement Permit with plat valid without expiration. Improvement Permit with site plan valid for sixty months. Authorization to Construct is valid for a period equal to that of Improvement Permit – not to exceed sixty months

Signed: RBoyle date 11-27-02 Installed by:

Improvement Permit by: Patrick Mitchell date 10/23/02 Operation Permit by: date

Authorization to Construct by: Patrick Mitchell date 10/23/02 Existing System Inspection by: date

HEALTH DEPT. COPY: WHITE OWNER COPY (FINAL): YELLOW OWNER COPY (INITIAL): PINK