#10696

IREDELL COUNTY HEALTH DEPARTMENT

CI 300.00 Paid

STATESVILLE 704-878-5305 MOORESVILLE 704-664-5281

IMPROVEMENT PERMIT / AUTHORIZATION TO CONSTRUCT / OPERATION PERMIT / EXISTING SYSTEM INSPECTION

PERMIT# -2- TROUTMAN PIN# 3H-C-3

OWNER OR CONTRACTOR LARRY H. DAVIS PHONE: Business Home 664-9407 DATE 10/25/99

ADDRESS 450 OAK TREE RD

LOCATION PERTH RD (S) - TL SPICEWOOD - 5TH ON RT

SUBDIVISION SPICEWOOD BLOCK / SECTION LOT 26 LOT AREA .725 AC SITE CLASS PS DESIGN FLOW 360gal L.T.A.R. .3 gpd/ft²

Septic Tank: 1000 Gallons; STB 1012 Date 5-10-00

Pump Tank: Gallons; PT Date

Pump Make: Model Serial No.

Nitrification Field: No Fields 1 Square Feet 900 Linear Feet 300

No Lines 5 @ 60' Trench Width 36" Max Trench Bottom Depth 36"

☑ New System ☐ Repair System Type: I II III IV V VI

System Description: GRAVITY 25% REDUCTION

Repair System Description: PUMP PANEL

Maintenance Agreement Required: ☐ Yes ☑ No

Gravel Depth N/A ☐ Slab ☑ Crawl Space ☐ Basement w/plumbing ☐ Basement wo/plumbing

☑ House/Mod. Home No. Bedrooms 3

☐ Mobile Home No. Bathrooms 2

☐ Business No. Employees


☐ Other

Water Supply: ☐ Individual ☑ Public ☐ Community


Comments/Conditions: House 50x50' inclusive

Comments/Conditions: Septic Tank Risers + Poly Lok Filter Installed Septic Tank deep. Septic Lines installed deeper than 36".

INITIAL SITE SKETCH 1"=50'

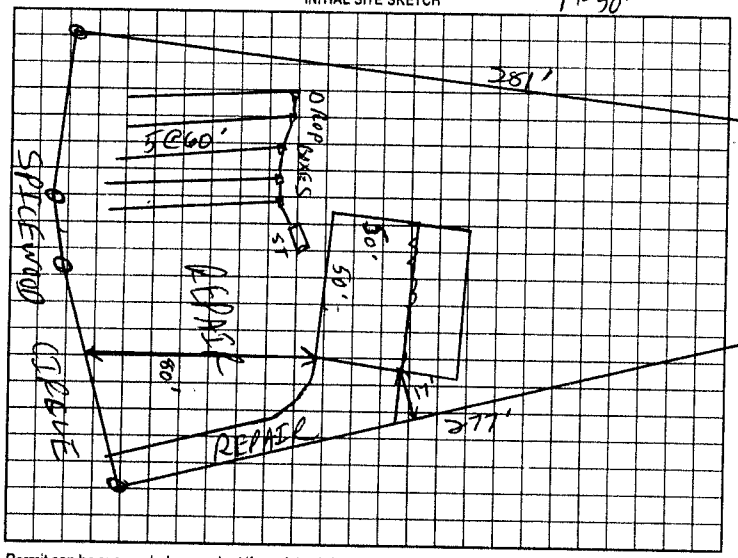

AS BUILT SKETCH

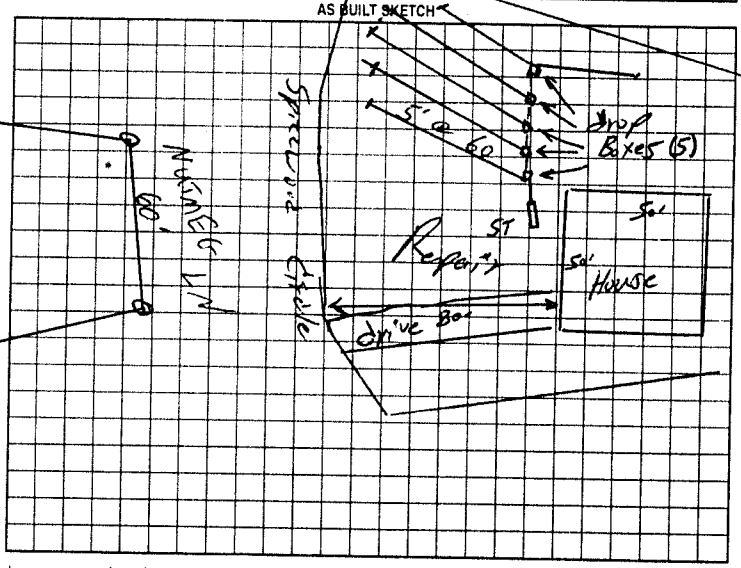

Permit can be suspended or revoked if any false information is supplied toward securing the permit/any unauthorized changes are made to the site/any unauthorized changes are made in the installation of the system. Improvement Permit with plat valid without expiration. Improvement Permit with site plan valid for sixty months. Authorization to Construct is valid for a period equal to that of Improvement Permit – not to exceed sixty months.

Signed: Larry H Davis date 5/14/01 Installed by: Richard Abernathy

Improvement Permit by: C. Bart Lam RS date 10/25/99 Operation Permit by: William O. Johnson date 7/23/02

Authorization to Construct by: William O. Johnson date 5/29/02 Existing System Inspection by: date

HEALTH DEPT COPY WHITE OWNER COPY (FINAL) YELLOW OWNER COPY (INITIAL) PINK