IREDELL COUNTY HEALTH DEPARTMENT

STATESVILLE 704-878-5305 MOORESVILLE 704-664-5281

IMPROVEMENT PERMIT / AUTHORIZATION TO CONSTRUCT / OPERATION PERMIT / EXISTING SYSTEM INSPECTION

PERMIT# Repair PIN# 4730801772 DATE 7/26/04

OWNER OR CONTRACTOR New Path Corp. PHONE: Business 704-662-3427 Home

ADDRESS 190 Points End Dr. Mooresville NC 28117

LOCATION Perth, TL Shady Cove, TL Alfara on Rt At End #130

SUBDIVISION Shady Cove BLOCK / SECTION LOT 30 LOT AREA 29,837 Ft² SITE CLASS. P5 DESIGN FLOW 360 L.T.A.R. —

Septic Tank: Existing Gallons; STB Date

Pump Tank: Gallons; PT Date

Pump Make: Model Serial No.

Nitrification Field: No Fields 1 Square Feet 720 Linear Feet 60'

No Lines 3 Trench Width 12' Max Trench Bottom Depth — Gravel Depth —

☐ New System ☒ Repair System Type: I, II, III, IV, V, VI

System Description: 25% Reduction Bed

Repair System Description:

Maintenance Agreement Required: ☐ Yes ☒ No

☒ House/Mod. Home No. Bedrooms 3

☐ Mobile Home No. Bathrooms

☐ Business No. Employees

☐ Other

☐ Slab ☐ Crawl Space ☒ Basement w/plumbing ☐ Basement wo/plumbing


Water Supply: ☒ Individual ☐ Public ☐ Community Existing

Comments:/Conditions:

⊗ well

Comments:/Conditions:

INITIAL SITE SKETCH

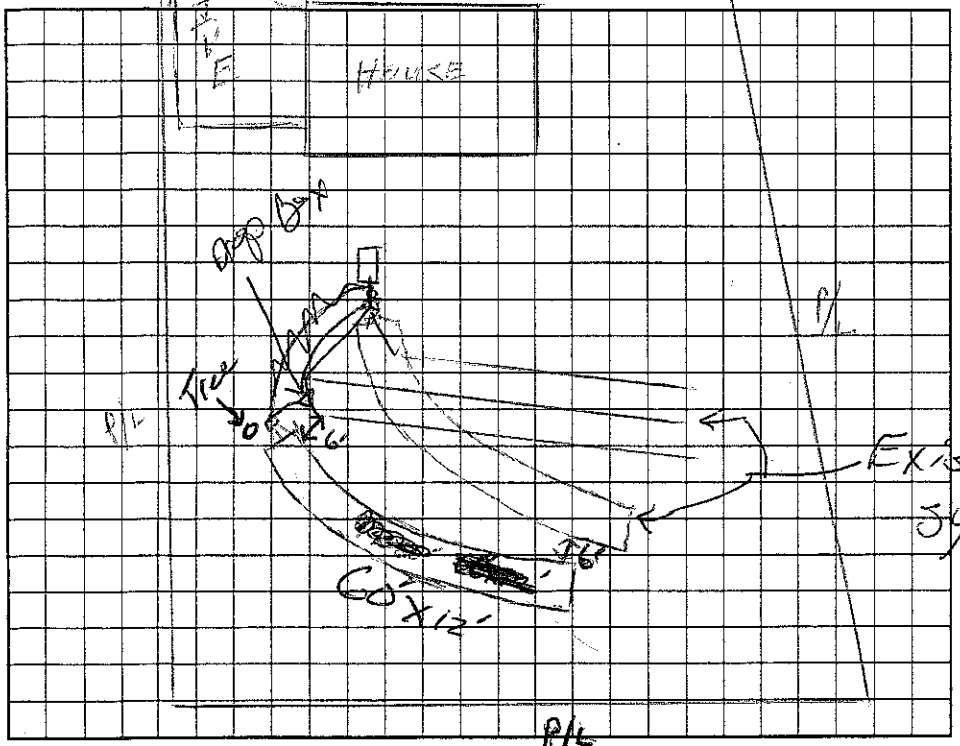

AS BUILT SKETCH

EZ Flow Installed

Permit can be suspended or revoked if any false information is supplied toward securing the permit/any unauthorized changes are made to the site/any unauthorized changes are made in the installation of the system. Improvement Permit with plat valid without expiration. Improvement Permit with site plan valid for sixty months. Authorization to Construct is valid for a period equal to that of Improvement Permit – not to exceed sixty months.

Signed: date 7/26/04

Improvement Permit by: RS date 7/26/04

Authorization to Construct by: RS date 7/26/04

Installed by: Piedmont Septic

Operation Permit by: RS date 8/19/04

Existing System Inspection by: date

HEALTH DEPT. COPY: WHITE OWNER COPY (FINAL): YELLOW OWNER COPY (INITIAL): PINK