IREDELL COUNTY HEALTH DEPARTMENT

STATESVILLE 704-878-5305 MOORESVILLE 704-664-5281

IMPROVEMENT PERMIT / AUTHORIZATION TO CONSTRUCT / OPERATION PERMIT / EXISTING SYSTEM INSPECTION

PERMIT# 82037 PIN# 4730807616 DATE 7/9/99

OWNER OR CONTRACTOR HOMER HESS PHONE: Business Home

ADDRESS 122 LAWRENCE TEE LN. MOORESVILLE NC 28117

LOCATION PERTH RD - ON ~~RD~~ LT JUST AFTER CLONTZ HILL RD

SUBDIVISION SHADY COVE BLOCK / SECTION 2 LOT 1 LOT AREA .75 SITE CLASS. 15 DESIGN FLOW ~~300~~ 440 L.T.A.R. .3

Septic Tank: 1000 Gallons; STB 786 Date 7/9/99
Pump Tank: 1000 Gallons; PT 22 Date 6/15/99
Pump Make: Goulds Model PWE05111 Serial No. WE0514H
Nitrification Field: No Fields 1 Square Feet 533 Linear Feet 270
No Lines 4@67' Trench Width 36" Max Trench Bottom Depth 18" Gravel Depth 12"

☑ New System ☐ Repair System Type: I, II, III, IV, V, VI
System Description: PUMP CON VENTIONAL
Repair System Description: SAME
Maintenance Agreement Required: ☐ Yes ☑ No


☐ House/Mod. Home No. Bedrooms 2
☐ Mobile Home No. Bathrooms 2
☐ Business No. Employees
☐ Other
☐ Slab ☐ Crawl Space ☐ Basement w/plumbing ☐ Basement wo/plumbing

Water Supply: ☑ Individual ☐ Public ☐ Community


Comments/Conditions: Filter installed & riser

Comments/Conditions: Tanks, lines & pressure tested. 9/7/99 MZ

NO SCALE INITIAL SITE SKETCH

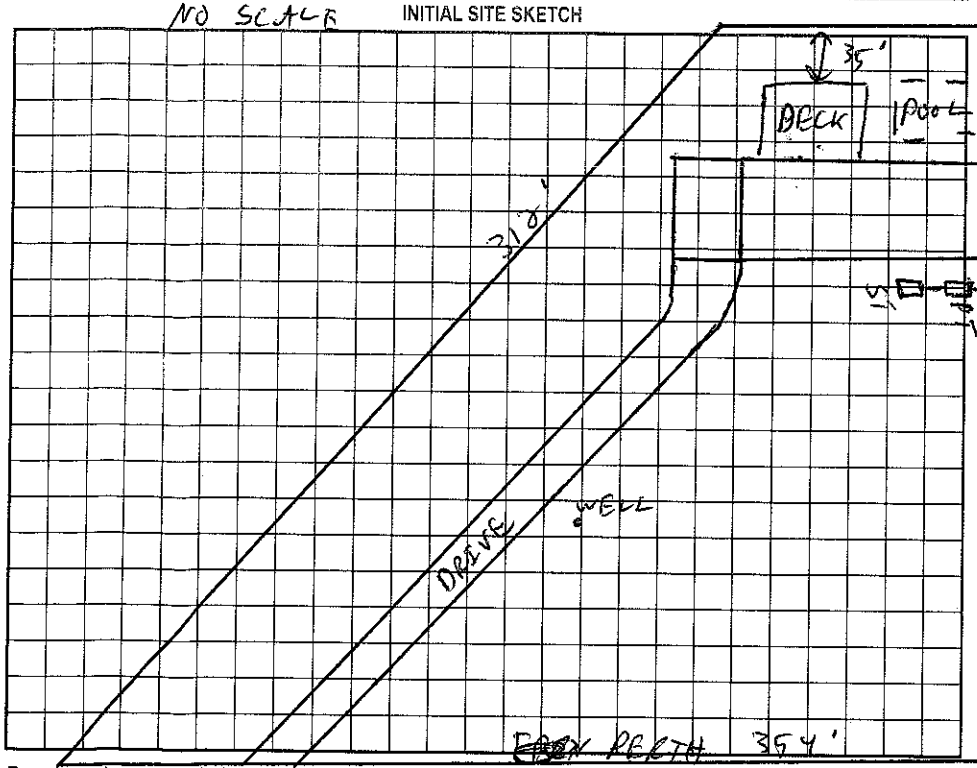

AS BUILT SKETCH

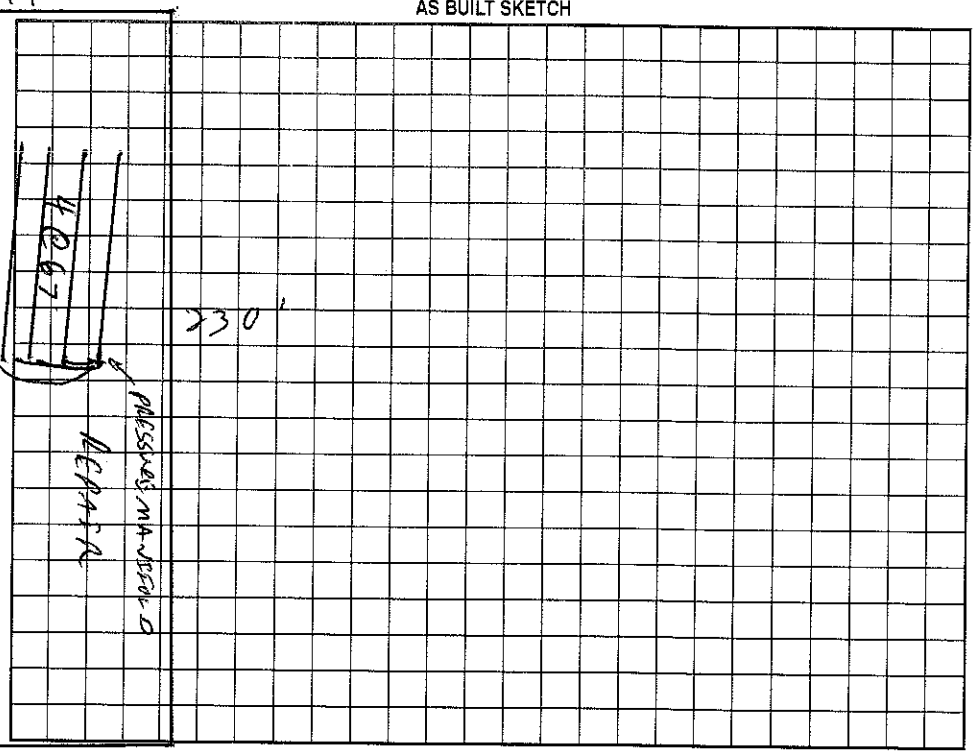

Permit can be suspended or revoked if any false information is supplied toward securing the permit/any unauthorized changes are made to the site/any unauthorized changes are made in the installation of the system. Improvement Permit with plat valid without expiration. Improvement Permit with site plan valid for sixty months. Authorization to Construct is valid for a period equal to that of Improvement Permit – not to exceed sixty months.

Signed: date

Improvement Permit by: C. R. RS date 7/9/99

Authorization to Construct by: C. R. RS date 7/9/99

Installed by: Leatherman's Septic

Operation Permit by: Mariah H. Dotson R.S. date 10/1/99

Existing System Inspection by: date

HEALTH DEPT. COPY: WHITE OWNER COPY (FINAL): YELLOW OWNER COPY (INITIAL): PINK