IREDELL COUNTY HEALTH DEPARTMENT

STATESVILLE 704-878-5305 MOORESVILLE 704-664-5281

IMPROVEMENT PERMIT / AUTHORIZATION TO CONSTRUCT / OPERATION PERMIT / EXISTING SYSTEM INSPECT.

1000-

PERMIT# 074120 PIN# 4730810188 DATE 6/8/98

OWNER OR CONTRACTOR HOPE BROTHERS PHONE: Business 872-4111 Home

ADDRESS 1120 BARKLEY RD

LOCATION PERTH RD - TL SHADY COVE - TL MILLARD LN ON LT.

SUBDIVISION SHADY COVE BLOCK / SECTION 2 LOT 45 LOT AREA SITE CLASS. RS DESIGN FLOW 360 GPD L.T.A.R. .3 GPD/FT²

Septic Tank: 1000 Gallons; STB 1012 Date 7-11-99

Pump Tank: 1000 Gallons; PT 27 Date 5-8-9[illegible]

Pump Make: Goulds Model WE05114 Serial No. J993193

Nitrification Field: No Fields 1 Square Feet 900 Linear Feet 300

No Lines 4@75' Trench Width 36" Max Trench Bottom Depth 36" Gravel Depth N/A

☑ New System ☐ Repair System Type: I, II, (III) IV, V, VI

System Description: PUMP CHAMBERS OR HDS

Repair System Description: SAME

Maintenance Agreement Required: ☐ Yes ☑ No

☑ House/Mod. Home No. Bedrooms 3

☐ Mobile Home No. Bathrooms 2

☐ Business No. Employees

☐ Other


Water Supply: ☑ Individual ☐ Public ☐ Community

☐ Slab ☑ Crawl Space ☐ Basement w/plumbing ☐ Basement wo/plumbing

Comments:/Conditions: Filter & riser installed

Comments:/Conditions: Uncovered tanks & lines 10/4/99 mk

INITIAL SITE SKETCH 1"=50'

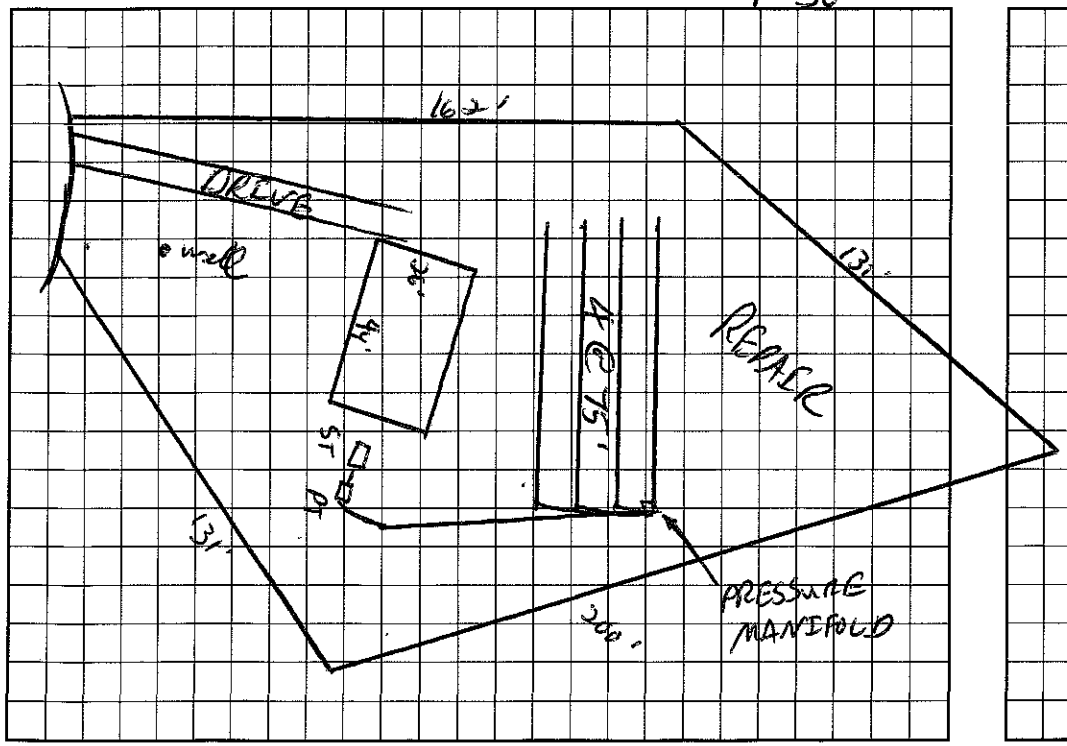

AS BUILT SKETCH

I understand that this permit can be suspended or revoked if any false information is supplied toward securing the permit/any unauthorized changes are made to the site/any unauthorized changes are made in the installation of the system. Improvement Permit with plat valid without expiration. Improvement Permit with site plan valid for sixty months. Authorization to Construct is valid for a period equal to that of Improvement Permit – not to exceed sixty months.

Signed: [signature] date 6-11-98 Installed by: Hope Brothers Bldg. Co.

Improvement Permit by: C. [signature] RS date 6/8/98 Operation Permit by: Wesley Sparks RS. date 10/27/99

Authorization to Construct by: C. [signature] RS date 6/8/98 Existing System Inspection by: date

HEALTH DEPT. COPY: WHITE INSPECTION COPY (FINAL): GREEN OWNER COPY (FINAL): YELLOW INSPECTION COPY (INITIAL): PINK OWNER COPY (INITIAL): GOLD