IREDELL COUNTY HEALTH DEPARTMENT

STATESVILLE 704-878-5305 MOORESVILLE 704-664-5281

IMPROVEMENT PERMIT / CERTIFICATE OF COMPLETION / OPERATION PERMIT / EXISTING SYSTEM INSPECTION

PROPERTY DESCRIPTION NO. 20580 DATE 4/4/95 TAX MAP NO. 3F 9A 94 4730 81 0340 Watershed: ☑ Yes ☐ No

OWNER OR CONTRACTOR Tim Hope PHONE: Business 881-1944 Home

ADDRESS 105 Holbrook Ct. Statesville, NC.

LOCATION Shady Cove, Perth N. (L) on Shady Cove (L) first road to cul-de-sac on (L) of corner

SUBDIVISION Shady Cove BLOCK / SECTION II LOT #4 LOT AREA 1 acre SITE CLASS. P DESIGN FLOW 360 L.T.A.R. .3-.35

Septic Tank: 1000 V Gallons; STB 794 Date 7/14/95

Pump Tank: 1000 V Gallons; PT 27 Date 2/9/95

Pump Make: Model Serial No.

Nitrification Field: No Fields 1 Square Feet 1200 Linear Feet 400

No Lines 3 Trench Width 36" Max Trench Bottom Depth 32" Gravel Depth 12"

☑ New System ☐ Repair System Type: I, II, ☑ III, IV, V, VI

System Description: Pressure to Conv.

Repair System Description: Sewer

Maintenance Agreement Required: ☐ Yes ☑ No

☑ House/Mod. Home No. Bedrooms 3

☐ Mobile Home No. Bathrooms 2

☐ Business No. Employees

☐ Other


☑ Slab ☐ Crawl Space ☐ Basement w/plumbing ☐ Basement wo/plumbing

Water Supply: ☑ Individual ☐ Community ☐ Public

Comments:

Comments: Outside Alarm - Electric Box used

INITIAL SITE SKETCH

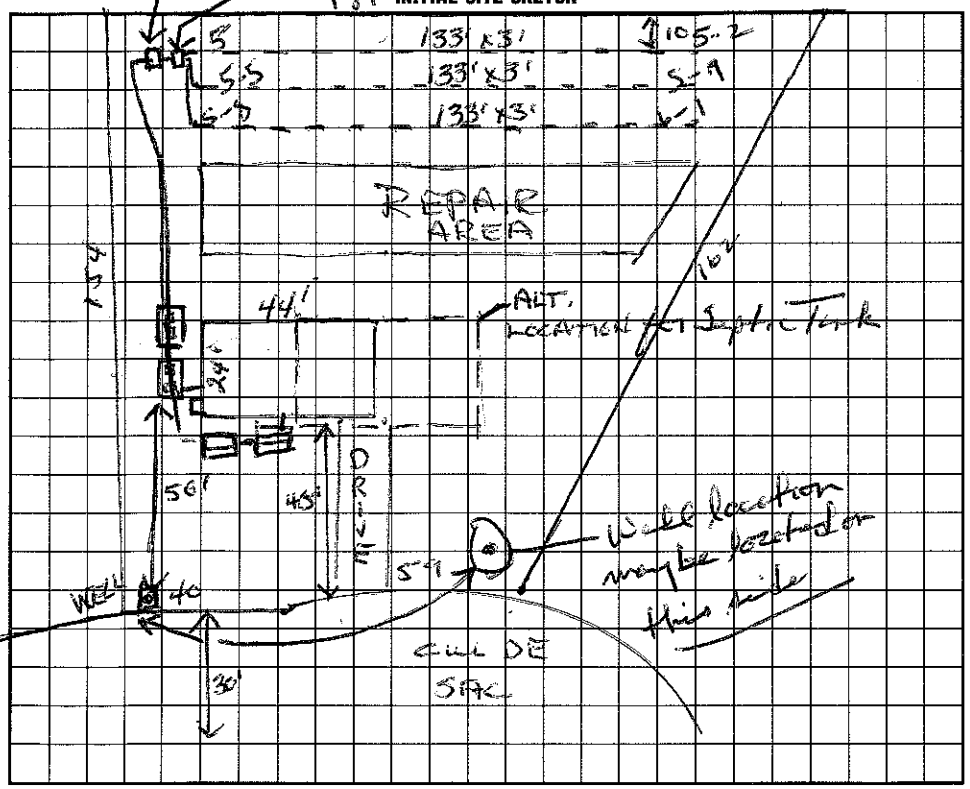

AS BUILT SKETCH

I understand that this permit can be suspended or revoked if any false information is supplied toward securing the permit/any unauthorized changes are made to the site/any unauthorized changes are made in the installation of the system. Improvement Permit is valid for 60 months from date of issuance.

Signed:

Improvement Permit by: Wesley Sparks R.S. date 4/4/95

Existing System Inspection by: date

Installed by: Andy Daniels

Certificate of Completion by: Wesley Sparks R.S. date 7/1/97

Operation Permit by: Wesley Sparks R.S. date 7/1/97

HEALTH DEPT. COPY: WHITE INSPECTION COPY (FINAL): GREEN OWNER COPY (FINAL): YELLOW INSPECTION COPY (INITIAL): PINK OWNER COPY (INITIAL): GOLD