4730810683

IREDELL COUNTY HEALTH DEPARTMENT

STATESVILLE 704-878-5305 MOORESVILLE 704-664-5281

IMPROVEMENT PERMIT / CERTIFICATE OF COMPLETION / OPERATION PERMIT / EXISTING SYSTEM INSPECTION

PROPERTY DESCRIPTION NO. REPAIR DATE 1-6-96 TAX MAP NO. Watershed: ☐ Yes ☑ No

OWNER OR CONTRACTOR JAMES H. & DOROTHY BAITY PHONE: Business 664-1134 Home 528-9632

ADDRESS 1218 PERTH CHURCH ROAD STATESMAN, NC 28

LOCATION PERTH CHURCH ROAD North, ON LEFT BEFORE SKIPPERS LANDING AT BOX # 1218

SUBDIVISION BLOCK / SECTION LOT LOT AREA LIMITED SITE CLASS PS DESIGN FLOW 360 L.T.A.R. EXISTING

Septic Tank: EXISTING Gallons; STB Date

Pump Tank: Gallons; PT Date

Pump Make: Model Serial No.

Nitrification Field: No Fields 1 Square Feet 300 Linear Feet 50

No Lines 1 BED Trench Width 72" Max Trench Bottom Depth 42"

☐ New System ☑ Repair System Type: I II III IV V VI

System Description: CONV. GRAVITY

Repair System Description: CONV. GRAVITY

Maintenance Agreement Required: ☐ Yes ☑ No

Gravel Depth 24" ☐ Slab ☑ Crawl Space ☐ Basement w/plumbing ☐ Basement wo/plumbing

☑ House/Mod. Home No. Bedrooms 3

☐ Mobile Home No. Bathrooms 2

☐ Business No. Employees


☐ Other

Water Supply: ☑ Individual ☐ Community ☐ Public WELL

Comments: ① PUMP OUT SEPTIC TANK, REPLACE SANITARY TEE IF NECESSARY ② INSTALL DROP BOX AS STEP DOWN AT LOCATION SHOWN ③ INSTALL NEW 6'X50' BED USING 24" STONE ④ PIPE GUTTER DRAINS AWAY FROM SYSTEM.

Comments:

INITIAL SITE SKETCH

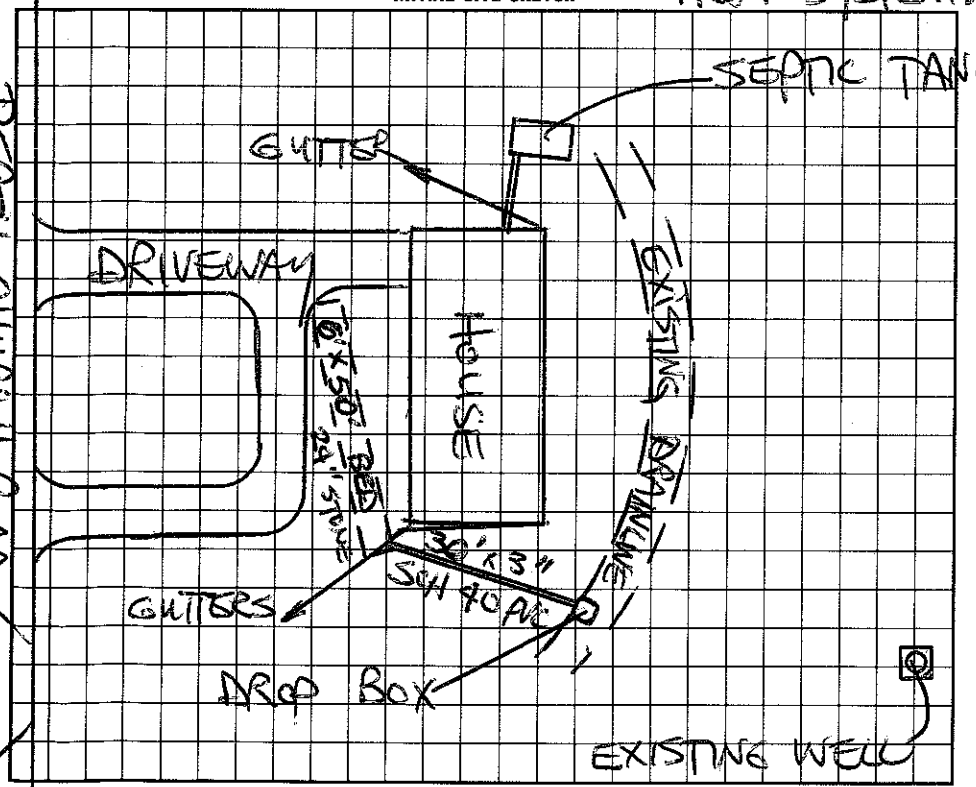

AS BUILT SKETCH

Same as initial site sketch

I understand that this permit can be suspended or revoked if any false information is supplied toward securing the permit/any unauthorized changes are made to the site/any unauthorized changes are made in the installation of the system. AUTHORIZATION TO CONSTRUCT IS VALID FIVE (5) YEARS FROM ~~DATE~~ OF ISSUANCE. IMPROVEMENT PERMIT HAS NO EXPIRATION ~~DATE~~

Signed: X Dorothy Baity

Installed by: Wes Lytton

Improvement Permit by: STEVE HEDRICK date 1-6-96

~~Certificate of Completion~~ by: date

AUTHORIZATION TO CONSTRUCT

~~Existing System Inspection~~ by: STEVE HEDRICK date 1-6-96

Operation Permit by: C. Brady Thomas EHSI date 4/11/96

HEALTH DEPT. COPY: WHITE INSPECTION COPY (FINAL): GREEN OWNER COPY (FINAL): YELLOW INSPECTION COPY (INITIAL): PINK OWNER COPY (INITIAL): GOLD