IREDELL COUNTY HEALTH DEPARTMENT

STATESVILLE 704-878-5305 ☒ MOORESVILLE 704-664-5281

IMPROVEMENT PERMIT / AUTHORIZATION TO CONSTRUCT / OPERATION PERMIT / EXISTING SYSTEM INSPECTION

PERMIT # REPAIR PIN # 4730-82-5787 DATE 9-10-12

OWNER or APPLICANT KATHRYN PALLATIN PHONE: Business 704-507-4900 Home:

OWNER or APPLICANT ADDRESS 165 HAMPTON COVE RD

LOCATION / DIRECTIONS PERTH, CLONTZ MILL, HAMPTON COVE, ON L

SUBDIVISION WADE CLONTZ BLOCK / SECTION LOT # 6 LOT AREA .5AC DESIGN FLOW 360 L.T.A.R. .25

Septic Tank 1000 Gallons: STB 760 Date 5-16

Pump Tank Gallons: P T Date

Pump Make Model Serial #

Nitrification Field No Fields No Lines x 1 Linear Feet

Trench Width Max. Trench Bottom Depth Gravel Depth

☐ New System ☒ Repair ☐ Expansion System Type I II (III) IV V VI

System Description: TANK

Repair System Description:

Maintenance Agreement Required ☐ YES ☒ NO

☒ GRAVITY ☐ PRESSURE


☒ Residence No. Bedrooms 3 ☐ Business No. Persons ☐ Other No. Employees ☐ Slab ☒ Crawl Space ☐ Basement w/plumbing ☐ Basement w/o plumbing

Water Supply ☒ Private ☐ Public ☐ Community


Comments / Conditions

Comments / Conditions

INITIAL SITE SKETCH

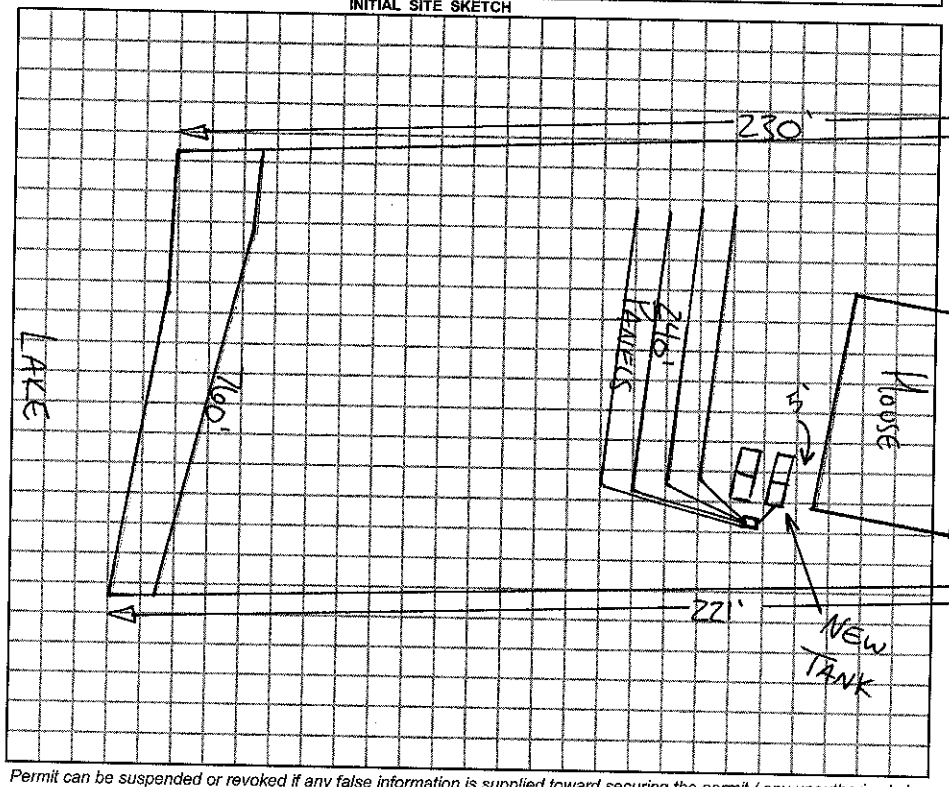

AS BUILT SKETCH

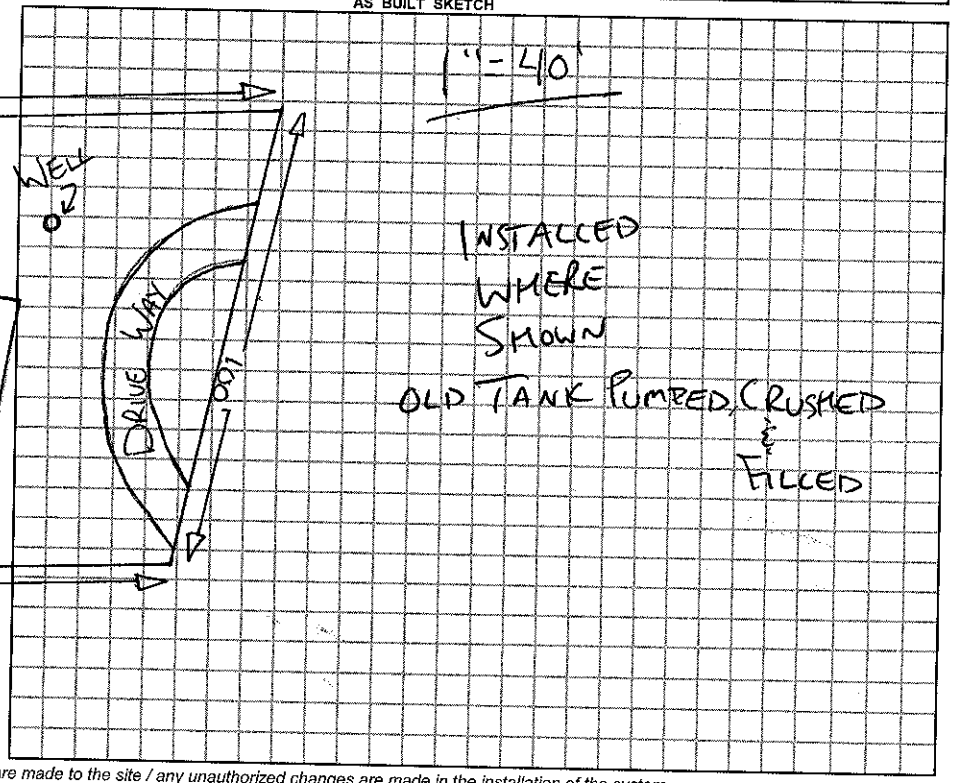

Permit can be suspended or revoked if any false information is supplied toward securing the permit / any unauthorized changes are made to the site / any unauthorized changes are made in the installation of the system.

☐ *IMPROVEMENT PERMIT w / plat valid without expiration.* ☒ *IMPROVEMENT PERMIT w / site plan valid for 60 mos.* ☒ *AUTHORIZATION TO CONSTRUCT valid for period equal to IMPROVEMENT PERMIT-not to exceed 60 mo.*

Owner / Applicant Signature: Date 9/10/12

Improvement Permit by: REHS Date 9-10-12

Authorzation to Construct by: REHS Date 9-10-12

YOU SHOULD CONTACT A LOCATOR SERVICE PRIOR TO ANY EXCAVATION.

Installed by: LENTZ

Operation Permit by: REHS Date: 9-26-12

Existing System Inspected by: Date:

WHITE COPY Environmental Health YELLOW COPY (Final) Owner / Applicant PINK COPY (Initial) Owner / Applicant