4730827987

IREDELL COUNTY HEALTH DEPARTMENT

STATESVILLE 704-878-5305 MOORESVILLE 704-664-5281

IMPROVEMENT PERMIT / CERTIFICATE OF COMPLETION / OPERATION PERMIT / EXISTING SYSTEM INSPECTION

PROPERTY DESCRIPTION NO. 26237 DATE 3/18/97 TAX MAP NO. 4730825844 Watershed: X Yes ☐ No

OWNER OR CONTRACTOR James A. Clontz PHONE: Business _____ Home 528-3809

ADDRESS 164 Hampton Cove Rd. Troutman, NC 28166

LOCATION Clontz Hill TR Hampton Cove Rd. 4th left after (L)

SUBDIVISION Wade H Clontz BLOCK / SECTION 1 LOT 4 LOT AREA Est 5 ac SITE CLASS. PS DESIGN FLOW 360 L.T.A.R. _____

Septic Tank: Existing Gallons; STB _____ Date _____

Pump Tank: _____ Gallons; PT _____ Date _____

Pump Make: _____ Model _____ Serial No. _____

Nitrification Field: No Fields ____ Square Feet Existing Sys Feet

No Lines _____ Trench Width _____ Max Trench Bottom Depth _____ Gravel Depth _____

☐ New System ☐ Repair System Type: I, II, III, IV, V, VI

System Description: Existing System

Repair System Description: _____

Maintenance Agreement Required: ☐ Yes X No

X House/Mod. Home No. Bedrooms 3

☐ Mobile Home No. Bathrooms 2

☐ Business No. Employees ____

☐ Other LN


☐ Slab ☐ Crawl Space ☐ Basement w/plumbing ☐ Basement wo/plumbing

Water Supply: X Individual ☐ Community ☐ Public


Comments:

Comments: 100 CONTOUR

INITIAL SITE SKETCH

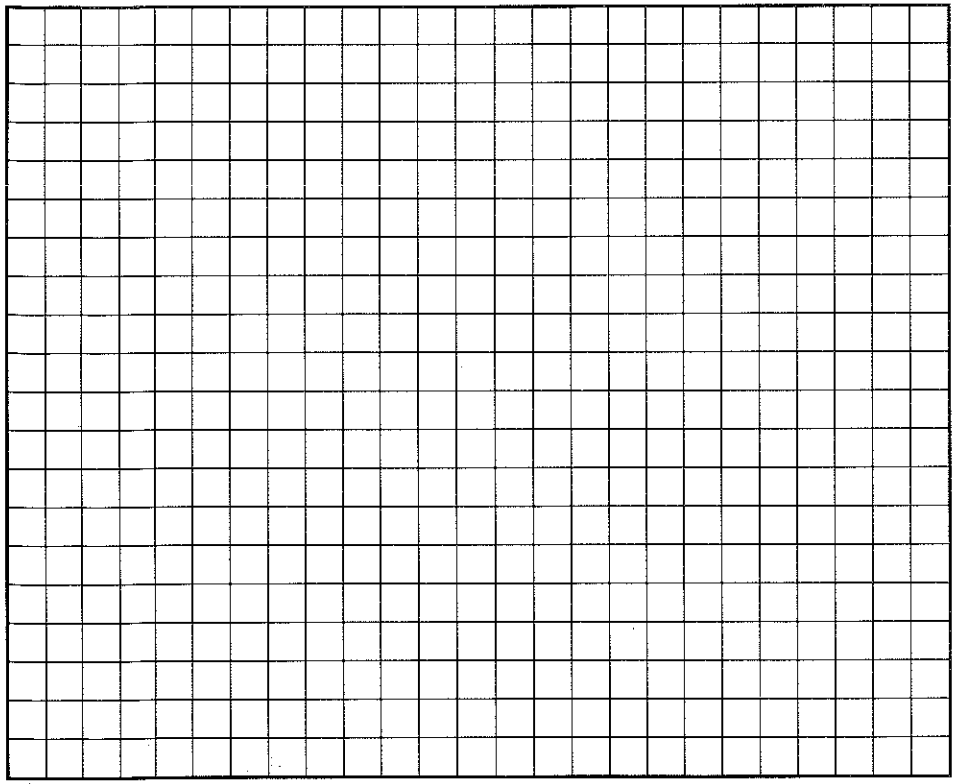

AS BUILT SKETCH

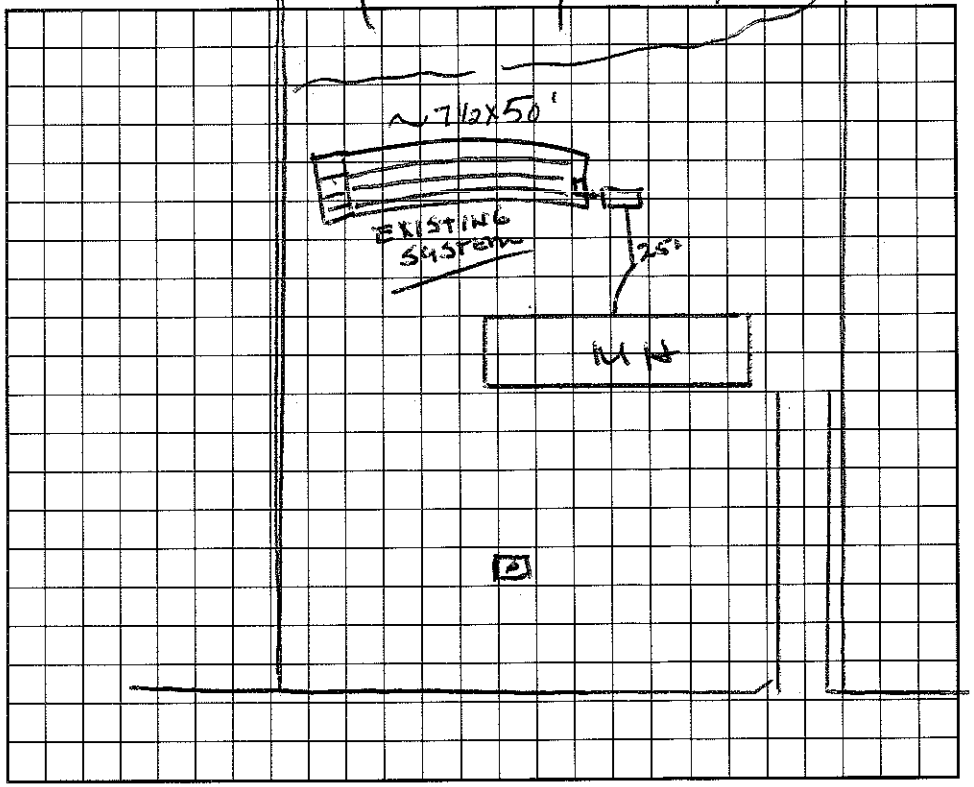

I understand that this permit can be suspended or revoked if any false information is supplied toward securing the permit/any unauthorized changes are made to the site/any unauthorized changes are made in the installation of the system. Improvement Permit is valid for 60 months from date of issuance.

Signed: _____

Improvement Permit by: _____ date _____

Existing System Inspection by: _____ date _____

Installed by: Existing System

Certificate of Completion by: Wesley Sparks R.S. date 3/18/97

Operation Permit by: Wesley Sparks R.S. date 3/18/97

HEALTH DEPT. COPY: WHITE INSPECTION COPY (FINAL): GREEN OWNER COPY (FINAL): YELLOW INSPECTION COPY (INITIAL): PINK OWNER COPY (INITIAL): GOLD