IREDELL COUNTY HEALTH DEPARTMENT

STATESVILLE 704-878-5305 MOORESVILLE 704-664-5281

IMPROVEMENT PERMIT / CERTIFICATE OF COMPLETION / OPERATION PERMIT / EXISTING SYSTEM INSPECTION

PROPERTY DESCRIPTION NO. 18329 DATE 5/2/94 TAX MAP NO. 3F 3A 6 Watershed: ☐ Yes ☒ No

OWNER OR CONTRACTOR ~~Kelly Long~~ KATHY PALLATAIN PHONE: Business BOMZE - 663-3655 Home

ADDRESS 4730826627

LOCATION HAMPTON COVE RD. ON (L) BEFORE NEXT TO LAST MH, 3RD LOT FROM END OF ROAD.

SUBDIVISION WADE CLONTZ BLOCK / SECTION LOT 6 LOT AREA ~1.5AC SITE CLASS. P DESIGN FLOW 360 L.T.A.R. .25

Septic Tank: 1000 Gallons; STB 794 Date 7/1/94

Pump Tank: Gallons; PT Date

Pump Make: Model Serial No.

Nitrification Field: No Fields 1 Square Feet 480 Linear Feet 240*

No Lines 3 4 Trench Width 2' Max Trench Bottom Depth 34-38" Gravel Depth 6" SAND

☑ New System ☐ Repair System Type: I, II, (III) IV, V, VI

System Description: 16" PPBPS

Repair System Description: SAME

Maintenance Agreement Required: ☐ Yes ☑ No

☑ House/Mod. Home No. Bedrooms 3

☐ Mobile Home No. Bathrooms 2

☐ Business No. Employees

☐ Other


☐ Slab ☑ Crawl Space ☐ Basement w/plumbing ☐ Basement wo/plumbing

Water Supply: ☑ Individual ☐ Community ☐ Public

Comments: ~~X~~ 16" PREFABRKATED PANEL BLOCKS DISTRIBUTION BOX WITH SPEED LEVELERS IF HOME MOVED TO BOTTOM OF SLOPE PUMPING WILL BE REQUIRED

Comments: As installed as shown on Imp. Permit

INITIAL SITE SKETCH

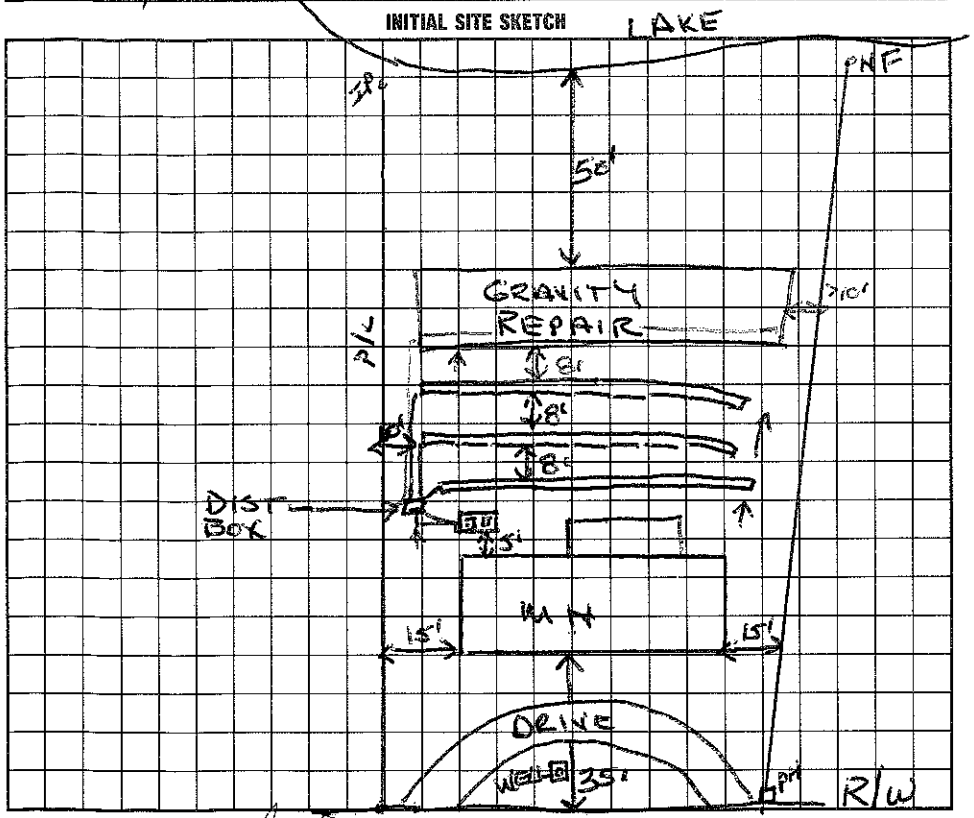

AS BUILT SKETCH

As installed as shown.

I understand that this permit can be suspended or revoked if any false information is supplied toward securing the permit/any unauthorized changes are made to the site/any unauthorized changes are made in the installation of the system. Improvement Permit is valid for 60 months from date of issuance. HAMPTON COVE RD.

Signed: Augustine Ramos

Improvement Permit by: Wesley Sparks RS. date 5/2/94

System Inspection by: date

Installed by: Wayne Dobson

Certificate of Completion by: Wesley Sparks RS. date 9/7/94

Operation Permit by: date

HEALTH DEPT. COPY: WHITE INSPECTION COPY (FINAL): GREEN OWNER COPY (FINAL): YELLOW INSPECTION COPY (INITIAL): PINK OWNER COPY (INITIAL): GOLD