IREDELL COUNTY HEALTH DEPARTMENT

STATESVILLE 704-878-5305 MOORESVILLE 704-664-5281

IMPROVEMENT PERMIT / CERTIFICATE OF COMPLETION / OPERATION PERMIT / EXISTING SYSTEM INSPECTION

PROPERTY DESCRIPTION NO. 18329 DATE 5/2/94 TAX MAP NO. 3F 3A 6 Watershed: ☐ Yes ☒ No

OWNER OR CONTRACTOR ~~Kelly Kemp~~ KATHY PALLATAIN PHONE: Business 80MZE-663-3655 Home

ADDRESS

LOCATION HAMPTON COVE RD. ON (L) BEFORE NEXT TO LAST MH, 3RD LOT FROM END OF ROAD.

SUBDIVISION WADE CLONTZ BLOCK / SECTION LOT 6 LOT AREA ~1.5AC SITE CLASS. P DESIGN FLOW 360 L.T.A.R. .125

Septic Tank: 1000 Gallons; STB 794 Date 7/1/94

Pump Tank: Gallons; PT Date

Pump Make: Model Serial No.

Nitrification Field: No Fields 1 Square Feet 480 Linear Feet 240*

No Lines ~~3~~ 4 Trench Width 2' Max Trench Bottom Depth 34-38" Gravel Depth 6" SAND

☒ New System ☐ Repair System Type: I, II, (III) IV, V, VI

System Description: 16" PPBPS

Repair System Description: SAME

Maintenance Agreement Required: ☐ Yes ☒ No

☒ House/Mod. Home ☐ Mobile Home ☐ Business ☐ Other

No. Bedrooms 3 No. Bathrooms 2 No. Employees


☐ Slab ☒ Crawl Space ☐ Basement w/plumbing ☐ Basement wo/plumbing

Water Supply: ☒ Individual ☐ Community ☐ Public


Comments: ~~X~~ 16" PREFABRICATED PANEL BLOCKS DISTRIBUTION BOX WITH SPEED LEVELERS IF HOME MOVED TO BOTTOM OF SLOPE PUMPING WILL BE REQUIRED

Comments: Installed as shown on Imp. Permit

INITIAL SITE SKETCH

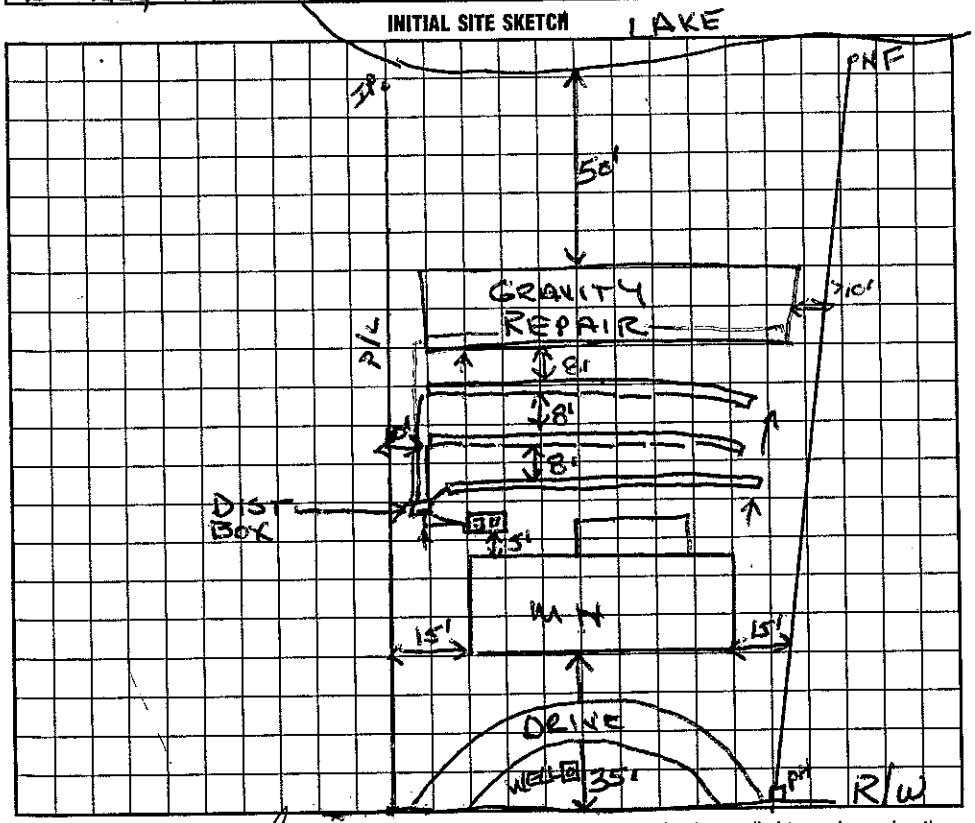

AS BUILT SKETCH

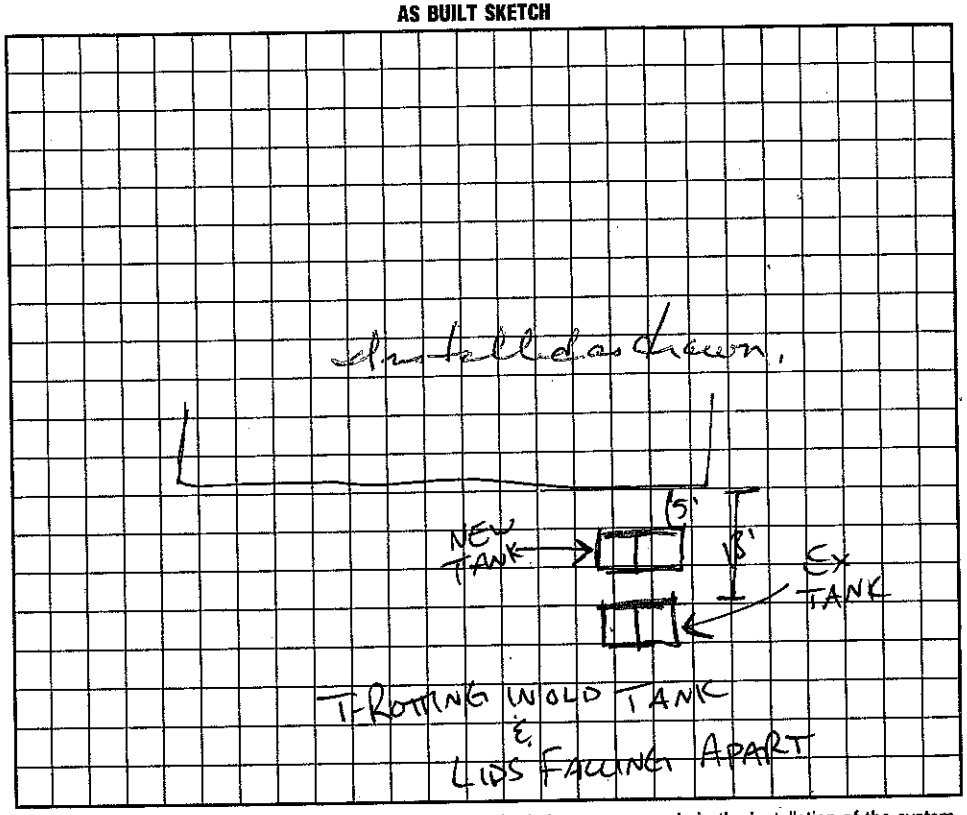

I understand that this permit can be suspended or revoked if any false information is supplied toward securing the permit/any unauthorized changes are made to the site/any unauthorized changes are made in the installation of the system. Improvement Permit is valid for 60 months from date of issuance. HAMPTON COVE RD.

Signed:

Improvement Permit by: Wesley Sparks RS. date 5/2/94

Final Inspection by: date

Installed by: Wayne Orbison

Certificate of Completion by: Wesley Sparks RS. date 9/7/94

Operation Permit by: date

HEALTH DEPT. COPY: WHITE INSPECTION COPY (FINAL): GREEN OWNER COPY (FINAL): YELLOW INSPECTION COPY (INITIAL): PINK OWNER COPY (INITIAL): GOLD