IREDELL COUNTY HEALTH DEPARTMENT

STATESVILLE 704-878-5305 MOORESVILLE 704-664-5281

IMPROVEMENT PERMIT / AUTHORIZATION TO CONSTRUCT / OPERATION PERMIT / EXISTING SYSTEM INSPECTION

PERMIT # 103 P97 PIN # 4730914810 DATE 2-22-2010

OWNER or APPLICANT Dave Greth PHONE: Business 704 873-9202 Home: 704 682-3647

OWNER or APPLICANT ADDRESS 372 Seven Springs Lp. Statesville NC 28625

LOCATION / DIRECTIONS Perth Rd N TR Wade Clontz Hill Rd. TL Hamptons Cove on left

SUBDIVISION Wade Clontz BLOCK / SECTION LOT # 14 LOT AREA 1.5Ac. DESIGN FLOW 360 L.T.A.R. .25 - .275

Septic Tank 1000 Gallons: STB 312 Date 1-13-10
Pump Tank Gallons: P T Date
Pump Make Model Serial #
Nitrification Field No Fields 1 No Lines 4 Linear Feet 350'
Trench Width 36" Max. Trench Bottom Depth 28" Gravel Depth N/A

☒ New System ☐ Repair ☐ Expansion System Type I II III IV V VI
System Description: Gravity - 25% Reduction
Repair System Description: LP. - Panel Block
Maintenance Agreement Required ☐ YES ☒ NO
☐ GRAVITY ☐ PRESSURE


☒ Residence No. Bedrooms 3
☐ Business No. Persons
☐ Other No. Employees
☐ Slab ☐ Crawl Space
☐ Basement w/plumbing ☒ Basement w/o plumbing

Water Supply: ☒ Private ☐ Public ☐ Community


Comments / Conditions: ☒ Must keep ST at least 50ft From Well.
** Divert surface / storm water away From Drainfield

Comments / Conditions: This permit replaces previous permit dated 4-16-07 Keep Drainfield Shallow. Stub out plumbing high enough for gravity flow to ST.
* Do Not install in wet Conditions

INITIAL SITE SKETCH

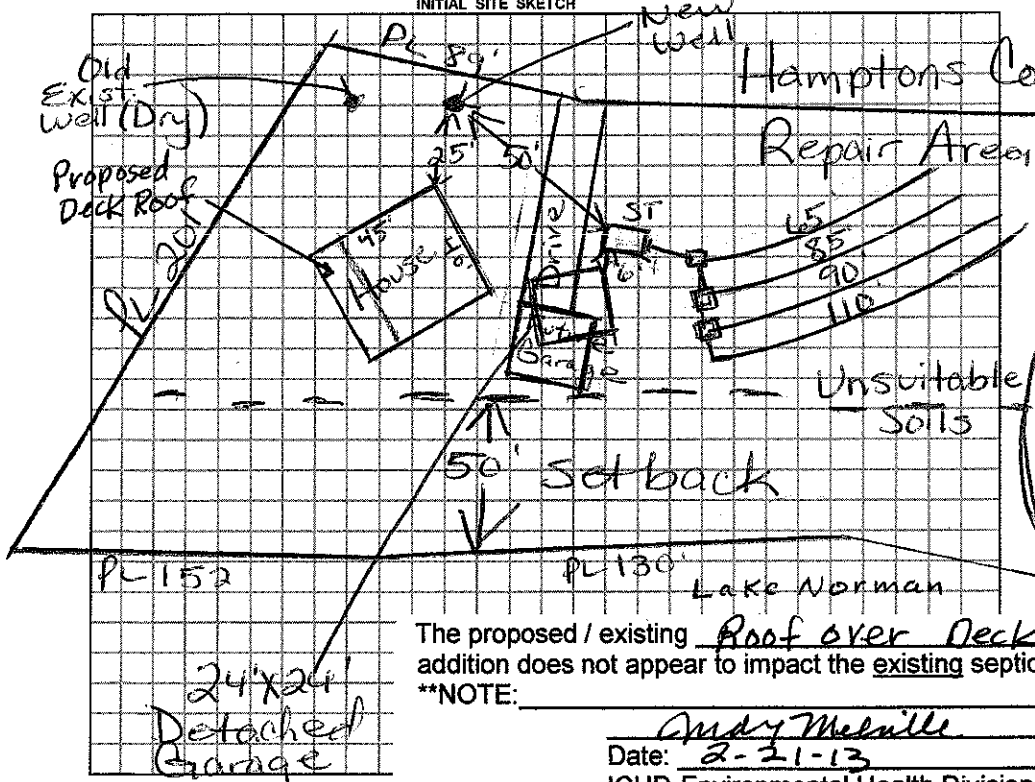

AS BUILT SKETCH

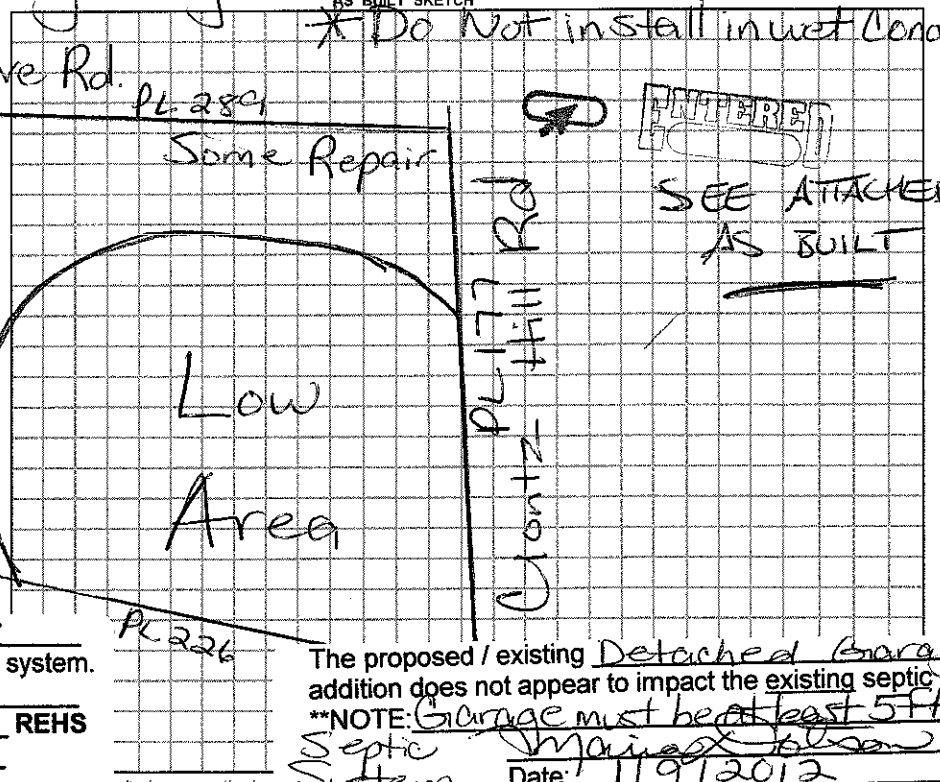

The proposed / existing Roof over Deck addition does not appear to impact the existing septic system.
**NOTE:

Andy Melville REHS
Date: 2-21-13
ICHD-Environmental Health Division

The proposed / existing Detached Garage addition does not appear to impact the existing septic system
**NOTE: Garage must be at least 5ft from

Maria H. Gibson REHS
Date: 11/9/2012
ICHD-Environmental Health Division

Permit can be suspended or revoked if a. site / any unauthorize

☐ IMPROVEMENT PERMIT w / plat valid without expiration. ☐ IMPROVEMENT PERMIT w / site plan valid for 60 mos. ☐ AUTHORIZATION TO CC

Owner / Applicant Signature: David Greth Date 2/23/2010 Installed by: RICHARD ARENWATHY

Improvement Permit by: Maria H. Gibson REHS Date 2/22/2010 Operation Permit by: [signature] REHS Date: 3-18-10

Authorzation to Construct by: Maria H. Gibson REHS Date 2/22/2010 Existing System Inspected by: Date:

YOU SHOULD CONTACT A LOCATOR SERVICE PRIOR TO ANY EXCAVATION.

WHITE COPY Environmental Health YELLOW COPY (Final) Owner / Applicant PINK COPY (Initial) Owner / Applicant