IREDELL COUNTY HEALTH DEPARTMENT

STATESVILLE 704-878-5305 MOORESVILLE 704-664-5281

IMPROVEMENT PERMIT / AUTHORIZATION TO CONSTRUCT / OPERATION PERMIT / EXISTING SYSTEM INSPECTION

PERMIT # 103097 PIN # 4730914810 DATE 2-22-2010

OWNER or APPLICANT Dave Greth PHONE: Business 704 873-9202 Home: 704 682-3647

OWNER or APPLICANT ADDRESS 372 Seven Springs Ln, Statesville NC 28625

LOCATION / DIRECTIONS Perth Rd N TR (Lontz Hill Rd. TL Hamptons Cove on left

SUBDIVISION Wade Lontz BLOCK / SECTION LOT # 14 LOT AREA 1.5Ac. DESIGN FLOW 360 L.T.A.R. .25 - .275

Septic Tank 1000 Gallons: STB 312 Date 1-13-10

Pump Tank Gallons: PT Date

Pump Make Model Serial #

Nitrification Field No Fields 1 No Lines 4 Linear Feet 350'

Trench Width 36" Max. Trench Bottom Depth 28" Gravel Depth N/A

☒ New System ☐ Repair ☐ Expansion System Type I II III IV V VI

System Description: Gravity -25% Reduction

Repair System Description: L.P. - Panel Block

Maintenance Agreement Required ☐ YES ☒ NO

☒ GRAVITY ☐ PRESSURE

☒ Residence No. Bedrooms 3

☐ Business No. Persons

☐ Other No. Employees

☐ Slab ☐ Crawl Space

☐ Basement w/plumbing ☒ Basement w/o plumbing


Water Supply: ☒ Private ☐ Public ☐ Community

Comments / Conditions: ☒ Must keep ST at least 50ft From Well.

** Divert surface/storm water away From Drainfield


Comments / Conditions: This permit replaces previous permit dated 4-16-07 Keep Drainfield Shallow Stub out plumbing high enough for gravity flow to ST.

INITIAL SITE SKETCH

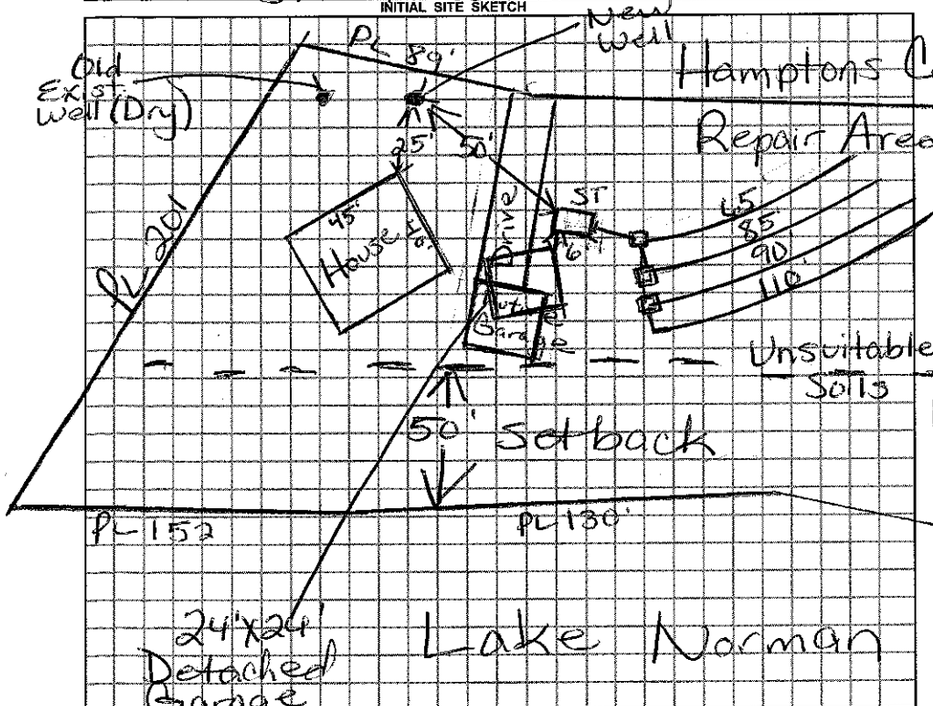

AS BUILT SKETCH

* Do Not install in wet Conditions

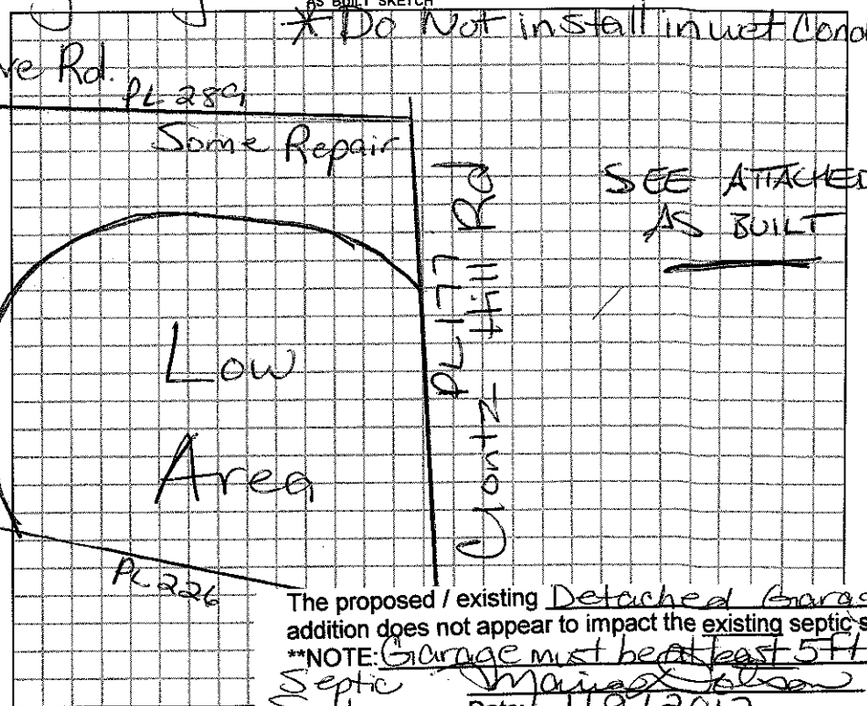

The proposed / existing Detached Garage addition does not appear to impact the existing septic system

**NOTE: Garage must be at least 5ft from Septic System

Marian Gibson REHS

Date: 11/9/2012

ICHD-Environmental Health Division

Permit can be suspended or revoked if any false information is supplied toward securing the permit / any unauthorized changes are made to the site / any unauthorize

☐ IMPROVEMENT PERMIT w / plat valid without expiration. ☐ IMPROVEMENT PERMIT w / site plan valid for 60 mos. ☐ AUTHORIZATION TO CO

Owner / Applicant Signature: David Greth Date 2/23/2010 Installed by: RICHARD ARERNATHY

Improvement Permit by: Marian Gibson RS Date 2/22/2010 Operation Permit by: REHS Date: 3-18-10

Authorization to Construct by: Marian Gibson RS Date 2/22/2010 Existing System Inspected by: Date:

YOU SHOULD CONTACT A LOCATOR SERVICE PRIOR TO ANY EXCAVATION.

WHITE COPY Environmental Health YELLOW COPY (Final) Owner / Applicant PINK COPY (Initial) Owner / Applicant