(3:00) (3:30)

IREDELL COUNTY HEALTH DEPARTMENT

STATESVILLE 704-878-5305 MOORESVILLE 704-664-5281

IMPROVEMENT PERMIT / AUTHORIZATION TO CONSTRUCT / OPERATION PERMIT / EXISTING SYSTEM INSPECTION

PERMIT# 081184 PIN# 4730917773 DATE 5/25/99

OWNER OR CONTRACTOR AH Contruction PHONE: Business _____ Home _____

ADDRESS 240 Auction Rd, China Grove NC 28069

LOCATION Perth, To Clontz Hill, TR Ridge Creek, 1st on Left 495 Clontz Hill Rd.

SUBDIVISION Rocky Creek BLOCK / SECTION _____ LOT 1 LOT AREA .5 SITE CLASS. PS DESIGN FLOW 360 L.T.A.R. .3

Septic Tank: 1000 Gallons; STB 825 Date _____
Pump Tank: _____ Gallons; PT _____ Date _____
Pump Make: _____ Model _____ Serial No. _____
Nitrification Field: No Fields 1 Square Feet 400 Linear Feet 300
No Lines 2@50'/2@100' Trench Width 36" Max Trench Bottom Depth 36" Gravel Depth N/A

☒ New System ☐ Repair System Type: I, II, III, IV, V, VI
System Description: 25% Rock
Repair System Description: Perk /
Maintenance Agreement Required: ☐ Yes ☒ No


☒ House/Mod. Home No. Bedrooms 3
☐ Mobile Home No. Bathrooms 2
☐ Business No. Employees ____
☐ Other _____
☐ Slab ☐ Crawl Space ☐ Basement w/plumbing ☐ Basement wo/plumbing

Water Supply:
~~☒~~ Individual
☐ Public
☐ Community

Comments:/Conditions: CONTOURS STRAIGHTER ACROSS LOT

Comments:/Conditions:

INITIAL SITE SKETCH

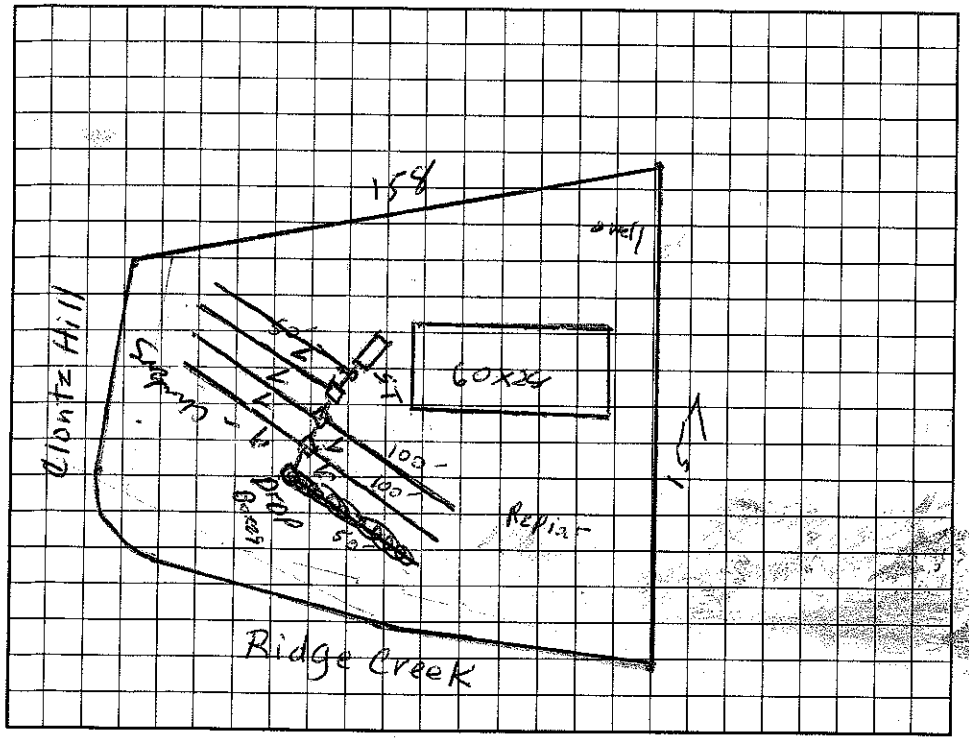

AS BUILT SKETCH

Permit can be suspended or revoked if any false information is supplied toward securing the permit/any unauthorized changes are made to the site/any unauthorized changes are made in the installation of the system. Improvement Permit with plat valid without expiration. Improvement Permit with site plan valid for sixty months. Authorization to Construct is valid for a period equal to that of Improvement Permit – not to exceed sixty months.

Signed: _____ date 5/26/99 Installed by: KOWAN SEPTIC

Improvement Permit by: Jeff Myers date 5/25/99 Operation Permit by: _____ date 6/25/99

Authorization to Construct by: Jeff Myers date 5/25/99 Existing System Inspection by: _____ date _____

HEALTH DEPT. COPY: WHITE OWNER COPY (FINAL): YELLOW OWNER COPY (INITIAL): PINK