IREDELL COUNTY HEALTH DEPARTMENT

Authorization to Construct 4730921278

STATESVILLE 704-878-5305 MOORESVILLE

IMPROVEMENT PERMIT / ~~CERTIFICATE OF COMPLETION~~ / OPERATION PERMIT / EXISTING SYSTEM

PROPERTY DESCRIPTION NO. Repair DATE 6/18/96 TAX MAP NO. N/A Watershed: [X] Yes [ ] No

OWNER OR CONTRACTOR Beatrice Reed PHONE: Business Home 664-2598

ADDRESS 134 Hampton Cove Rd.

LOCATION County Hwy 21 from South TL, to # 134 on (R) HAMPTON COVE RD.

SUBDIVISION N/A BLOCK / SECTION NA LOT LOT AREA SITE CLASS. PS DESIGN FLOW 240 L.T.A.R. .35

Septic Tank: Existing Gallons; STB Date

Pump Tank: Gallons; PT Date

Pump Make: Model Serial No.

Nitrification Field: No Fields 1 Square Feet 800 Linear Feet 170

No Lines 2 Trench Width 36" Max Trench Bottom Depth 36"+ Gravel Depth 6" SAND

[ ] New System [X] Repair System Type: I, II, (III), IV, V, VI

System Description: Ch Plastic

Repair System Description:

Maintenance Agreement Required: [ ] Yes [X] No

[X] House/Mod. Home No. Bedrooms 2

[ ] Mobile Home No. Bathrooms 1

[ ] Business No. Employees

[ ] Other

[ ] Slab [X] Crawl Space [ ] Basement w/plumbing [ ] Basement wo/plumbing


Water Supply: [X] Individual [ ] Community [ ] Public

Comments: Check Septic Tank and replace if necessary Speed Leveler in D/B

P/L

Comments: Installed as drawn.

INITIAL SITE SKETCH

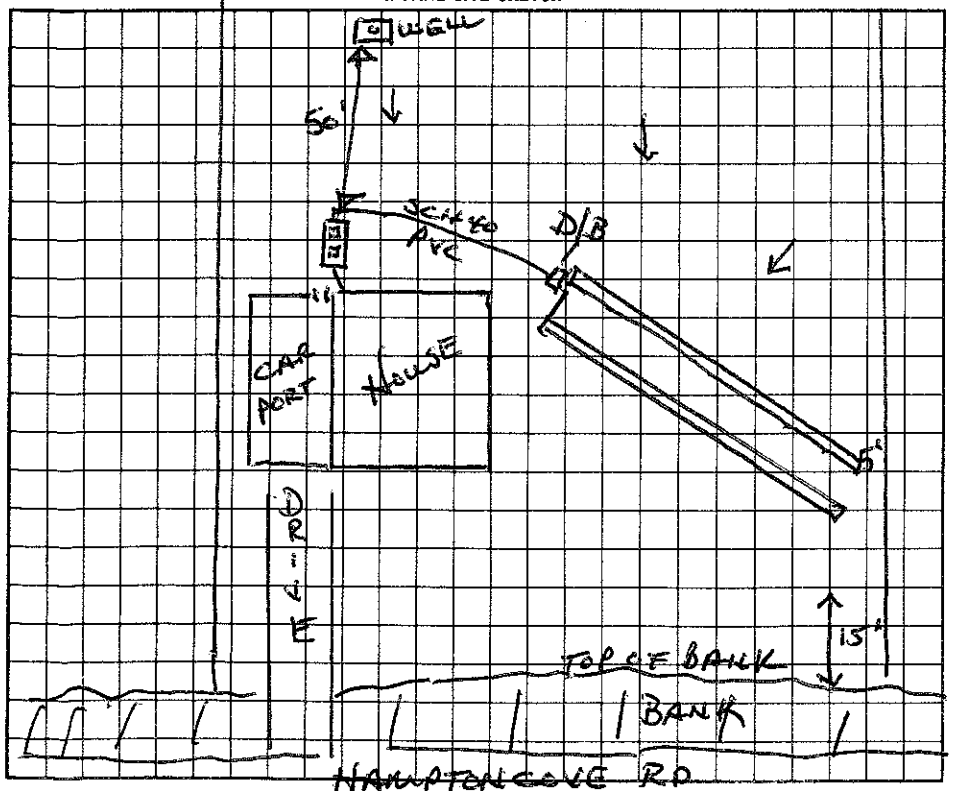

AS BUILT SKETCH

I understand that this permit can be suspended or revoked if any false information is supplied toward securing the permit/any unauthorized changes are made to the site/any unauthorized changes are made in the installation of the system.

Signed:

Installed by: Wayne County.

Improvement Permit by: date

Certificate of Completion by: date

Authorization to Construct Accepted by: Wesley Sparks RS 6/18/96

Operation Permit by: Wesley Sparks RS date 6/28/96

HEALTH DEPT. COPY: WHITE INSPECTION COPY (FINAL): GREEN OWNER COPY (FINAL): YELLOW INSPECTION COPY (INITIAL): PINK OWNER COPY (INITIAL): GOLD