IREDELL COUNTY HEALTH DEPARTMENT

STATESVILLE 704-878-5305 MOORESVILLE 704-664-5281

IMPROVEMENT PERMIT / CERTIFICATE OF COMPLETION / OPERATION PERMIT / EXISTING SYSTEM INSPECTION

PROPERTY DESCRIPTION NO. ~~2~~ 72998 DATE 4/17/98

OWNER OR CONTRACTOR Faye Parker TAX MAP NO. ~~4730~~ 4730 92 2197

ADDRESS 124 Hampton Cove Rd Troutman NC. PHONE: Business 663-1578 Home ~~663~~ 660-~~1516~~ 1517

LOCATION County Hill TR on Hampton Cove Rd. to 2ND lot on (L) (R) Watershed: ☐ Yes ☐ No

SUBDIVISION BLOCK / SECTION LOT LOT AREA SITE CLASS. DESIGN FLOW L.T.A.R.

Septic Tank: 1000 Gallons; STB 825 Date 9/28/98

Pump Tank: Gallons; PT Date

Pump Make: Model Serial No.

Nitrification Field: No Fields 1 Square Feet ~~*~~900 Linear Feet ~~*~~300

No Lines 3 Trench Width 36" Max Trench Bottom Depth 36" Gravel Depth SAND

☐ New System ☒ Repair System Type: I, II, (III), IV, V, VI

System Description: GRAV-CH

Repair System Description: SAME

Maintenance Agreement Required: ☐ Yes ☒ No

☒ House/Mod. Home No. Bedrooms 3

☐ Mobile Home No. Bathrooms 2

☐ Business No. Employees

☐ Other

☐ Slab ☒ Crawl Space ☐ Basement w/plumbing ☐ Basement wo/plumbing


Water Supply: ☒ Individual ☐ Community ☐ Public

Comments:

FENCE LINE

Comments:

INITIAL SITE SKETCH

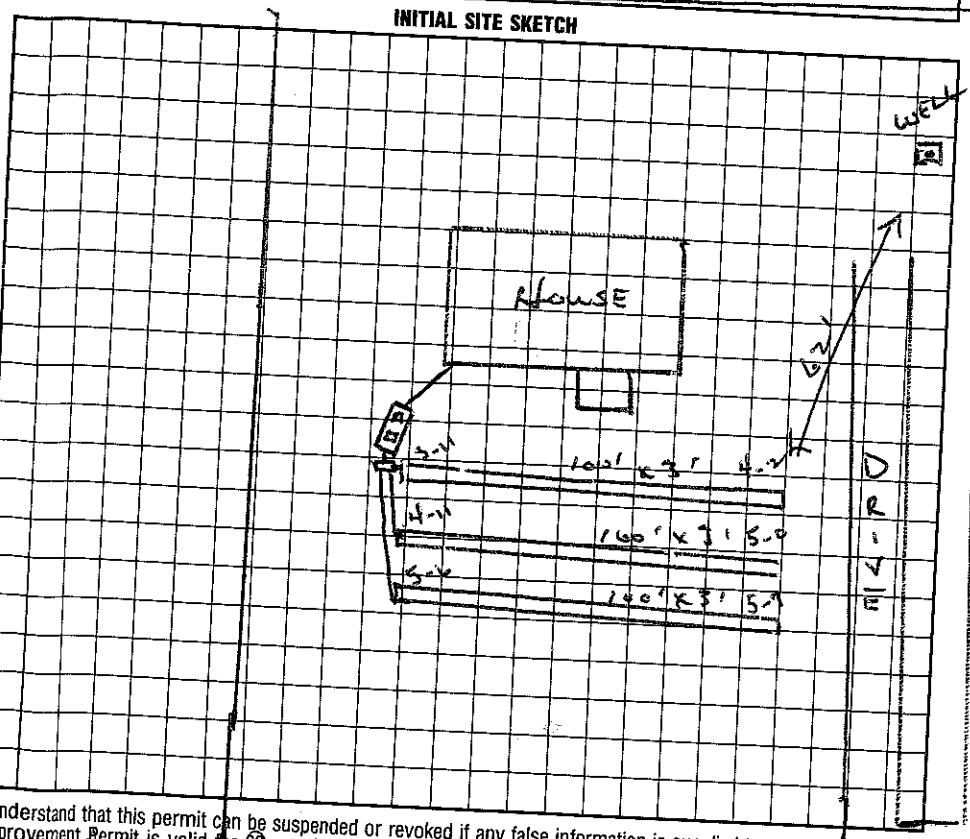

AS BUILT SKETCH

I understand that this permit can be suspended or revoked if any false information is supplied toward securing the permit/any unauthorized changes are made to the site/any unauthorized changes are made in the installation of the system. Improvement Permit is valid for 60 months from date of issuance.

Signed: Faye Parker HAMPTON COVE RD.

Improvement Permit by: Wesley Sparks RS. date 4/17/98

Existing System Inspection by: Wesley Sparks RS. date 4/17/98

Installed by: Wayne County.

Certificate of Completion by: date

Operation Permit by: Wesley Sparks RS. date 10/28/98

HEALTH DEPT. COPY: WHITE INSPECTION COPY (FINAL): GREEN OWNER COPY (FINAL): YELLOW INSPECTION COPY (INITIAL): PINK OWNER COPY (INITIAL): GOLD