IREDELL COUNTY HEALTH DEPARTMENT

STATESVILLE 704-878-5305 MOORESVILLE 704-664-5281

IMPROVEMENT PERMIT / AUTHORIZATION TO CONSTRUCT / OPERATION PERMIT / EXISTING SYSTEM INSPECTION

PERMIT # 162784 PIN # 4730925095 DATE 8-31-2010

OWNER or APPLICANT Oakwood Homes / Cynthia & Evan Lacoille PHONE: Business Home:

OWNER or APPLICANT ADDRESS 468 Clontz Hill Rd Troutman NC 28166

LOCATION / DIRECTIONS Hwy 21 N TL Flowerhouse TL Clontz Hill TR Hamptons Cove on corner

SUBDIVISION Clontz Prop BLOCK / SECTION LOT # 1 LOT AREA 1.113Ac DESIGN FLOW 360gpd L.T.A.R. .3

Septic Tank 1000 Gallons: STB 750 Date 6-10-10

Pump Tank Gallons: P T Date

Pump Make Model Serial #

Nitrification Field No Fields 1 No Lines 3 Linear Feet 306

Trench Width 36" Max. Trench Bottom Depth 36" Gravel Depth N/A

☒ New System ☐ Repair ☐ Expansion System Type I II III IV V VI

System Description: Gravity - 25% Reduct. LTAR .3

Repair System Description: Gravity - 50% Reduct.

Maintenance Agreement Required ☐ YES ☐ NO

☒ GRAVITY ☐ PRESSURE


☒ Residence No. Bedrooms 3 ☐ Business No. Persons ☐ Other No. Employees ☐ Slab ☐ Crawl Space ☐ Basement w/plumbing ☐ Basement w/o plumbing

Water Supply: ☒ Private ☐ Public ☐ Community


Comments / Conditions

Comments / Conditions This permit replaces permit issued 8-9-10 Septic System was not installed per plan therefore "redraw" had to be done.

INITIAL SITE SKETCH

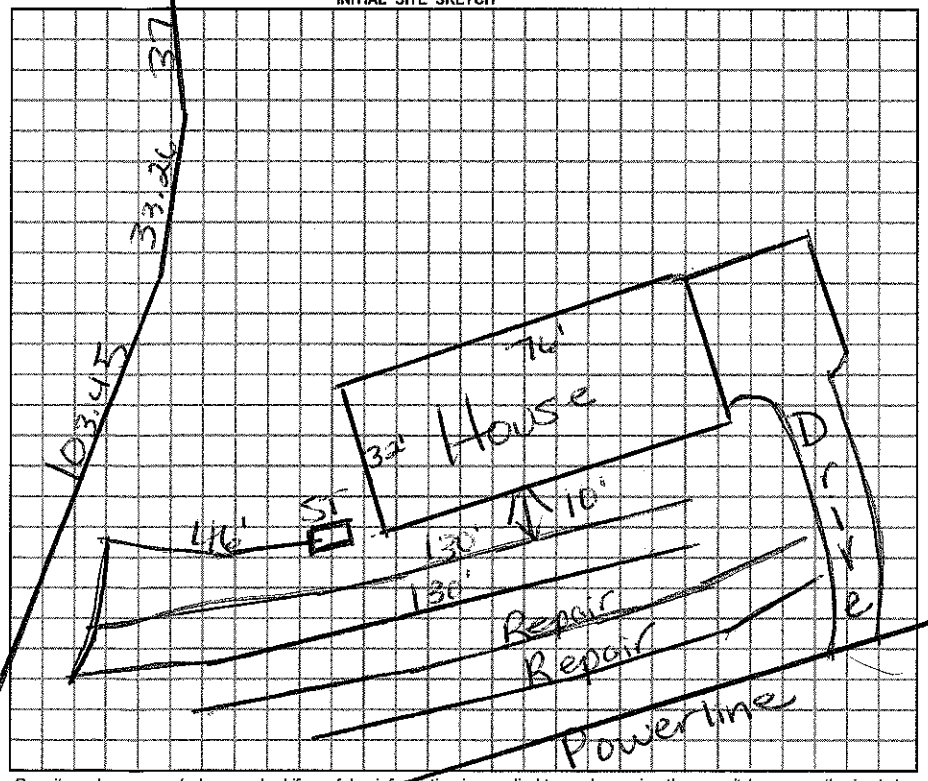

AS BUILT SKETCH

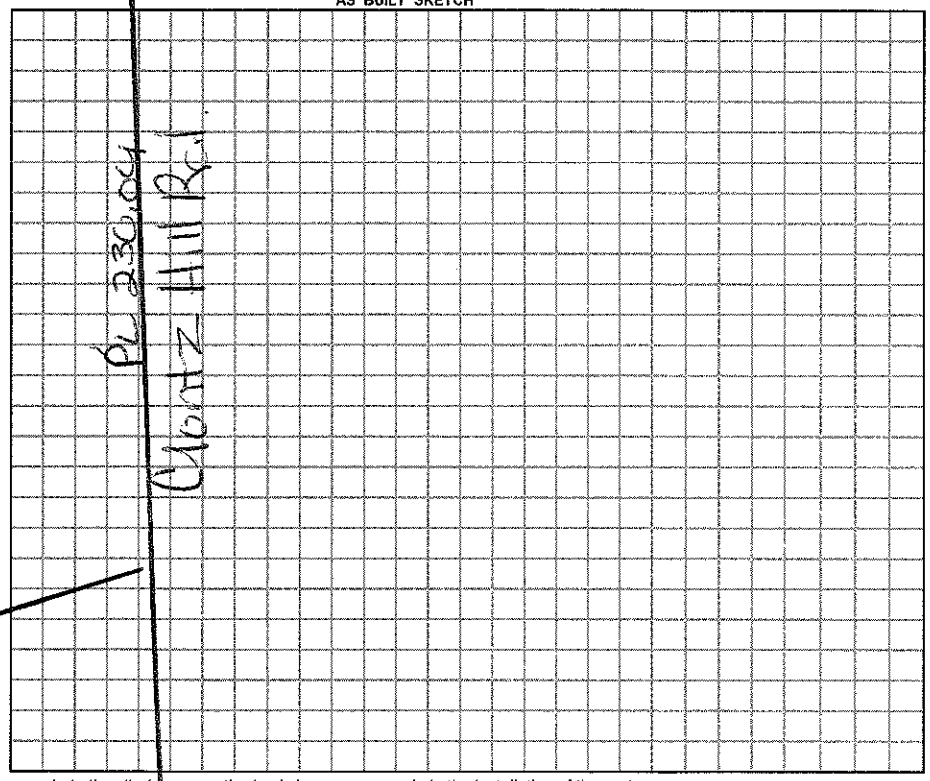

Permit can be suspended or revoked if any false information is supplied toward securing the permit / any unauthorized changes are made to the site / any unauthorized changes are made in the installation of the system.

☐ *IMPROVEMENT PERMIT w/ plat valid without expiration.* ☐ *IMPROVEMENT PERMIT w/ site plan valid for 60 mos.* ☐ *AUTHORIZATION TO CONSTRUCT valid for period equal to IMPROVEMENT PERMIT-not to exceed 60 mo.*

Hampton Cove Rd Pl 25.96

Owner / Applicant Signature: Date 9-14-10 Installed by: S&L Grading

Improvement Permit by: Maina Dotson Date 8/31/10 Operation Permit by: Maina Dotson Date: 8/31/10

Authorization to Construct by: Maina Dotson Date 8/31/10 Existing System Inspected by: Date:

YOU SHOULD CONTACT A LOCATOR SERVICE PRIOR TO ANY EXCAVATION.

WHITE COPY Environmental Health YELLOW COPY (Final) Owner / Applicant PINK COPY (Initial) Owner / Applicant