IREDELL COUNTY HEALTH DEPARTMENT

STATESVILLE 704-878-5305 MOORESVILLE 704-664-5281

IMPROVEMENT PERMIT / AUTHORIZATION TO CONSTRUCT / OPERATION PERMIT / EXISTING SYSTEM INSPECTION

PERMIT# 126924 PIN# 4731013599 7547 Cell DATE 3-11-05

OWNER OR CONTRACTOR William Turnstall PHONE: Business 779-9837 Home 896-7713

ADDRESS 21101 Bethel Church Rd Cornelius, Rd 28031

LOCATION East Monbo TL Talley Rd TR, Robin Crest down past pond to end of road on right in field

SUBDIVISION ____ BLOCK / SECTION ____ LOT ____ LOT AREA 20 Acres SITE CLASS. ____ DESIGN FLOW 360gpd L.T.A.R. .3

Septic Tank: 1000 Gallons; STB 794 Date 8-1-07

Pump Tank: ____ Gallons; PT ____ Date ____

Pump Make: ____ Model ____ Serial No. ____

Nitrification Field: No Fields 1 Square Feet 1197 Linear Feet 399

No Lines 3@133' Trench Width 36" Max Trench Bottom Depth 26" Gravel Depth 12"

X New System ☐ Repair System Type: I, II, III, IV, V, VI

System Description: Gravity-Conventional

Repair System Description: Pump-Conventional

Maintenance Agreement Required: ☐ Yes X No

X House/Mod. Home ☐ Mobile Home ☐ Business ☐ Other

No. Bedrooms 3 No. Bathrooms 3 No. Employees ____

☐ Slab X Crawl Space ☐ Basement w/plumbing ☐ Basement wo/plumbing


Water Supply: X Individual ☐ Public ☐ Community

Comments:/Conditions:


*Not to Scale

Comments:/Conditions: Note: Drainfield is greater than 50ft to creek. Stay 15' or greater to top of Slope or cut > 2ft.

INITIAL SITE SKETCH

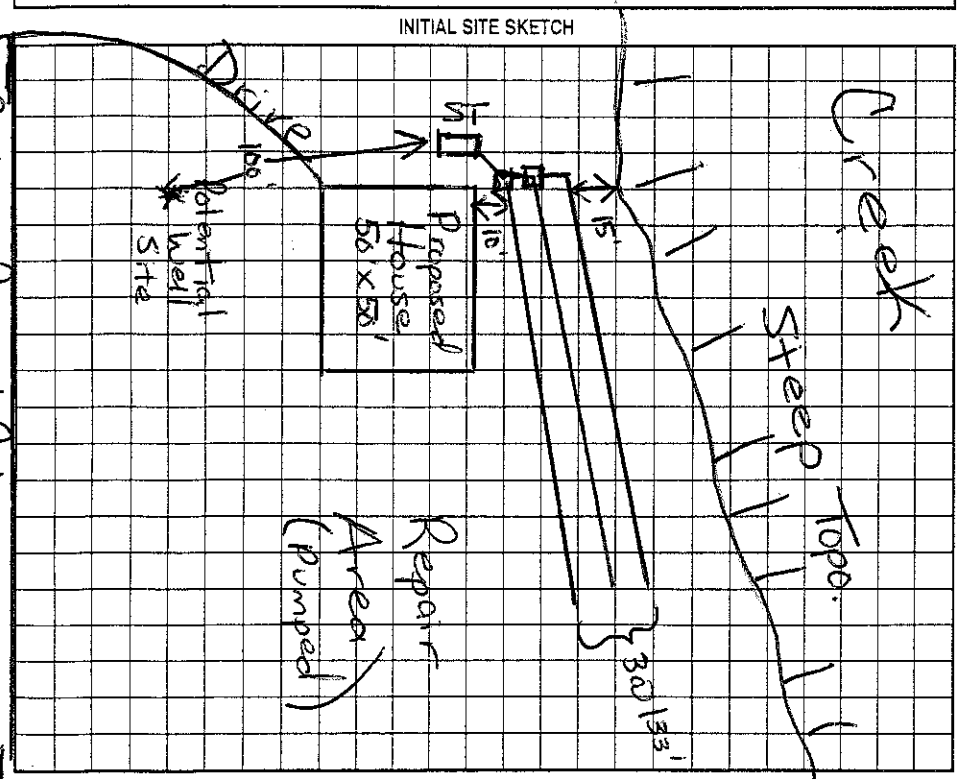

AS BUILT SKETCH

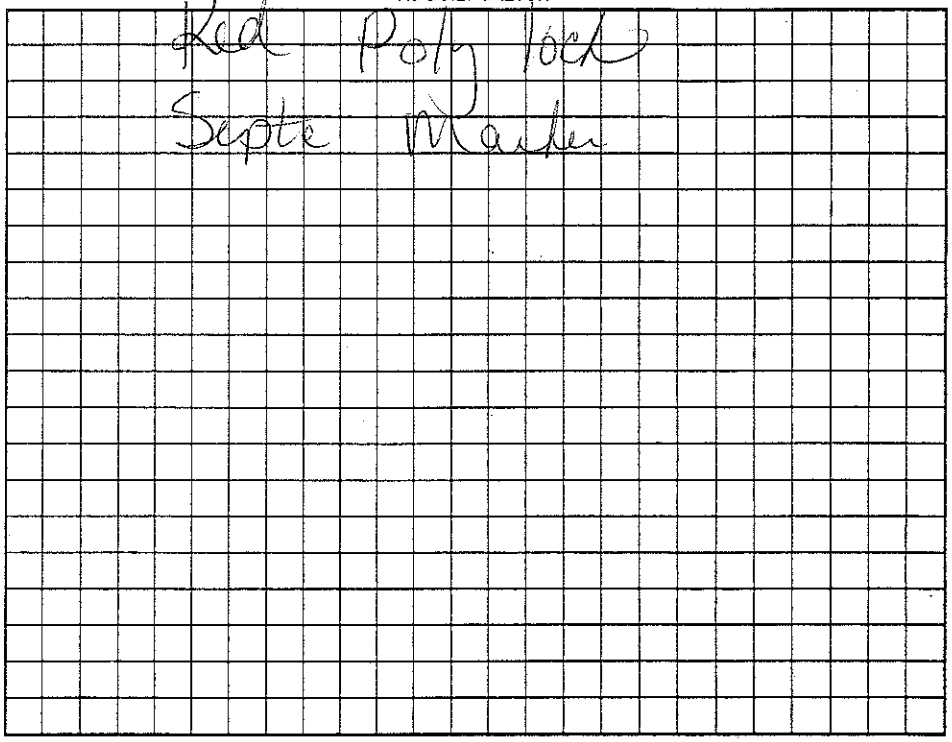

Permit can be suspended or revoked if any false information is supplied toward securing the permit/any unauthorized changes are made to the site/any unauthorized changes are made in the installation of the system. Improvement Permit with plat valid without expiration. Improvement Permit with site plan valid for sixty months. Authorization to Construct is valid for a period equal to that of Improvement Permit – not to exceed sixty months.

Signed: William A Turnstall Sr date 3-17-05 Installed by: H-1 Backhoe

Improvement Permit by: Maria H Robson RS date 3/11/05 Operation Permit by: Kelly Cook date 1-17-07

Authorization to Construct by: STEVE HEDRICK date 5/7/07 Existing System Inspection by: ____ date ____

HEALTH DEPT. COPY: WHITE OWNER COPY (FINAL): YELLOW OWNER COPY (INITIAL): PINK

