IREDELL COUNTY HEALTH DEPARTMENT

Statesville Office (704) 878-5305 Mooresville Office (704) 660-3625 PERMIT # 212796

IMPROVEMENT PERMIT / AUTHORIZATION TO CONSTRUCT / OPERATION PERMIT / EXISTING SYSTEM

PIN # 4731032636

APPLICANT: America's Home Place APPLICANT ADDRESS: 1206 Greenline Dr. Statesville

SITE ADDRESS: 714 Talley Rd. PHONE: 704-746-2094 ALT. PHONE: N/A

SITE DIRECTIONS: Hwy 115 S TR Talley Rd. ~2 miles on Right


SUBDIVISION: N/A SECTION: N/A LOT # N/A LOT AREA: 13.041 acres DESIGN FLOW: 480gpd L.T.A.R.: .0025

Septic Tank	1000 (gal)	STB	760	Date	7-6-15	☑ New System	☐ Repair	☐ Expansion	System Type: I II (III) IV V VI	☑ Residence	No. Bedrooms 4
Pump Tank	n/a (gal)	PT	n/a	Date	n/a	System Description:	25% Reduction			☐ Business	No. Persons 8
Pump Make	n/a	Model	Polyfoil	Serial #	PL-68	Repair System Description:	DRIP			☐ Other	No. Employees
# Nitrification Fields	1	# Lines	4	Linear Ft:	480	Maintenance Agreement Required:	☐ YES	☑ NO		☐ Slab	☑ Crawl Space
Trench Width	36"	Max. Trench Bottom Depth	36"	Gravel Depth	N/A		☑ GRAVITY	☐ PRESSURE		☐ Basement w/plumbing	☐ Basement w/o plumbing


Water Supply: ☑ Private ☐ Public ☐ Community

Comments / Conditions: Install a 25% Reduction system on contour with serial distribution. Grade out existing terrace below system area. Install trench bottoms @ 36" ~~AA~~

INITIAL SITE SKETCH

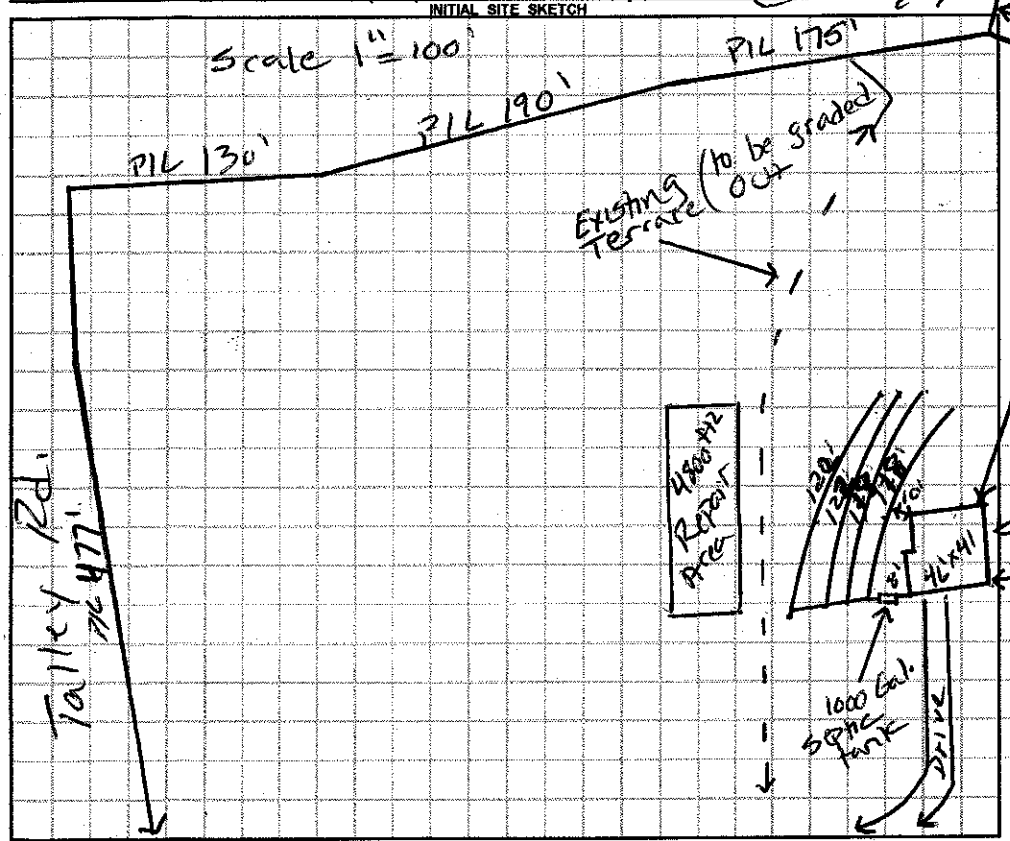

AS BUILT SKETCH

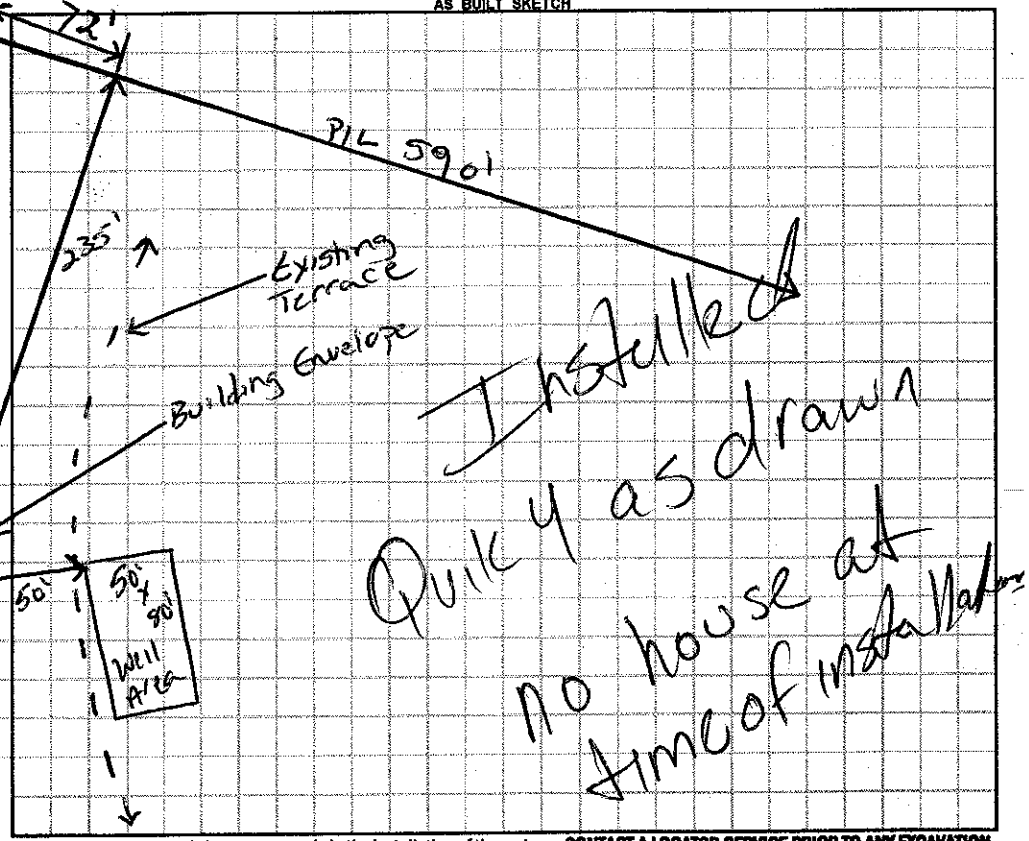

Permit can be suspended or revoked if any false information is supplied toward securing the permit / any unauthorized changes are made to the site / any unauthorized changes are made in the installation of the system. **CONTACT A LOCATOR SERVICE PRIOR TO ANY EXCAVATION**

☐ **IMPROVEMENT PERMIT** *with plat valid without expiration.* ☑ **IMPROVEMENT PERMIT** *with site plan valid for 60 mos.* ☑ **AUTHORIZATION TO CONSTRUCT** *valid for period equal to IMPROVEMENT PERMIT--not to exceed 60 mo.*

Owner / Applicant Signature: [signature] Date: 9/22/15 Installed by: Ground Breakers

IMPROVEMENT PERMIT by: Justin Henderson Date: 9-22-15 OPERATION PERMIT by: [signature] Date: 09/23/15

AUTHORIZATION TO CONSTRUCT by: Justin Henderson Date: 9-22-15 Existing System Inspected by: Date:

Health Dept. Copy - WHITE Applicant (Final Approval) - YELLOW Applicant (Conditional Approval) - PINK