IREDELL COUNTY HEALTH DEPARTMENT

Statesville Office (704) 878-5305 Mooresville Office (704) 660-3625 PERMIT # 202801 RF

IMPROVEMENT PERMIT / AUTHORIZATION TO CONSTRUCT / OPERATION PERMIT / EXISTING SYSTEM

PIN # 4731060475

APPLICANT: Larry Warren APPLICANT ADDRESS: 426 G. Monbo Rd

SITE ADDRESS: 426 G. Monbo Rd PHONE: 704-528-6163 ALT. PHONE: N/A

SITE DIRECTIONS: Hwy 1155 TR Old Mtn Rd TL East Monbo Rd Property on right ~ 1.5 miles


SUBDIVISION: N/A SECTION: N/A LOT # N/A LOT AREA: 1.0 acre DESIGN FLOW: 240gpd L.T.A.R.: 0.275

Septic Tank	Existing (gal)	STB		Date		☐ New System ☑ Repair ☐ Expansion	System Type: I II (III) IV V VI	☑ Residence	No. Bedrooms 2
Pump Tank	(gal)	PT		Date		System Description:		☐ Business	No. Persons 4
Pump Make		Model		Serial #		Repair System Description: 25% Reduction		☐ Other	No. Employees
# Nitrification Fields	1	# Lines	4	Linear Ft:	184'	Maintenance Agreement Required: ☐ YES ☑ NO		☐ Slab	☐ Crawl Space
Trench Width	36"	Max. Trench Bottom Depth	26"	Gravel Depth	N/A	☑ GRAVITY ☐ PRESSURE		☑ Basement w/plumbing	☐ Basement w/o plumbing


Water Supply: ☑ Private ☐ Public ☐ Community

Comments / Conditions: Install a 25% reduction system on contour with serial distribution. Install trenches at 26" on high side. Replace septic tank if needed.

INITIAL SITE SKETCH

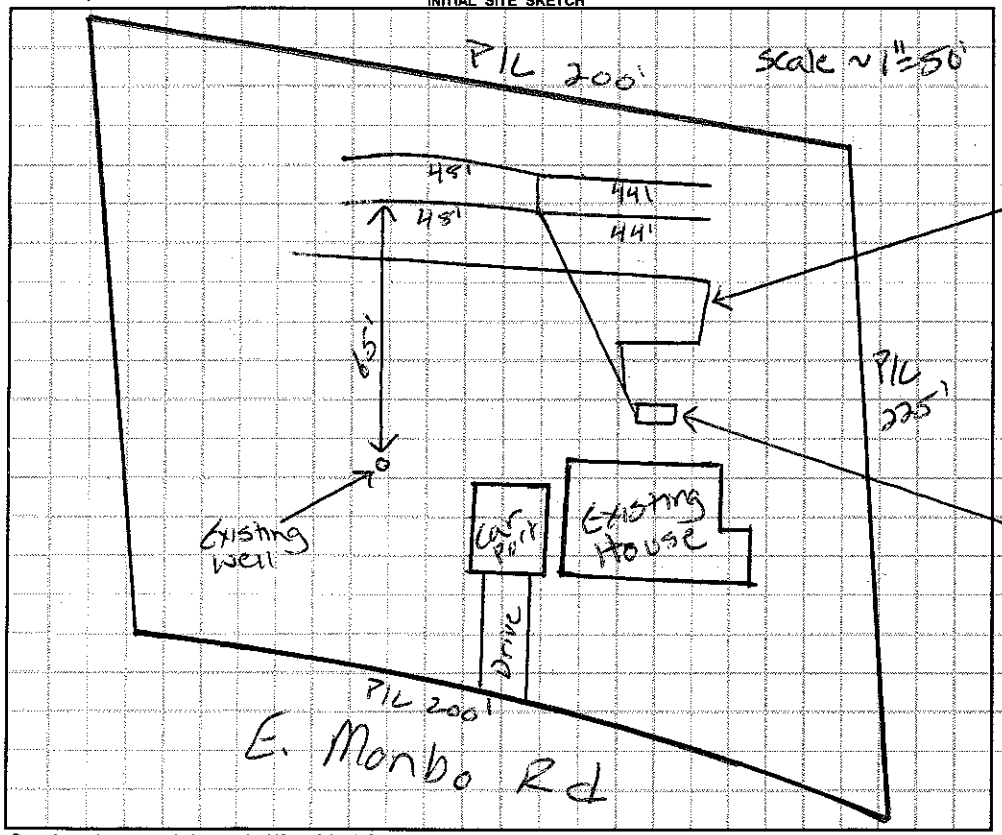

AS BUILT SKETCH

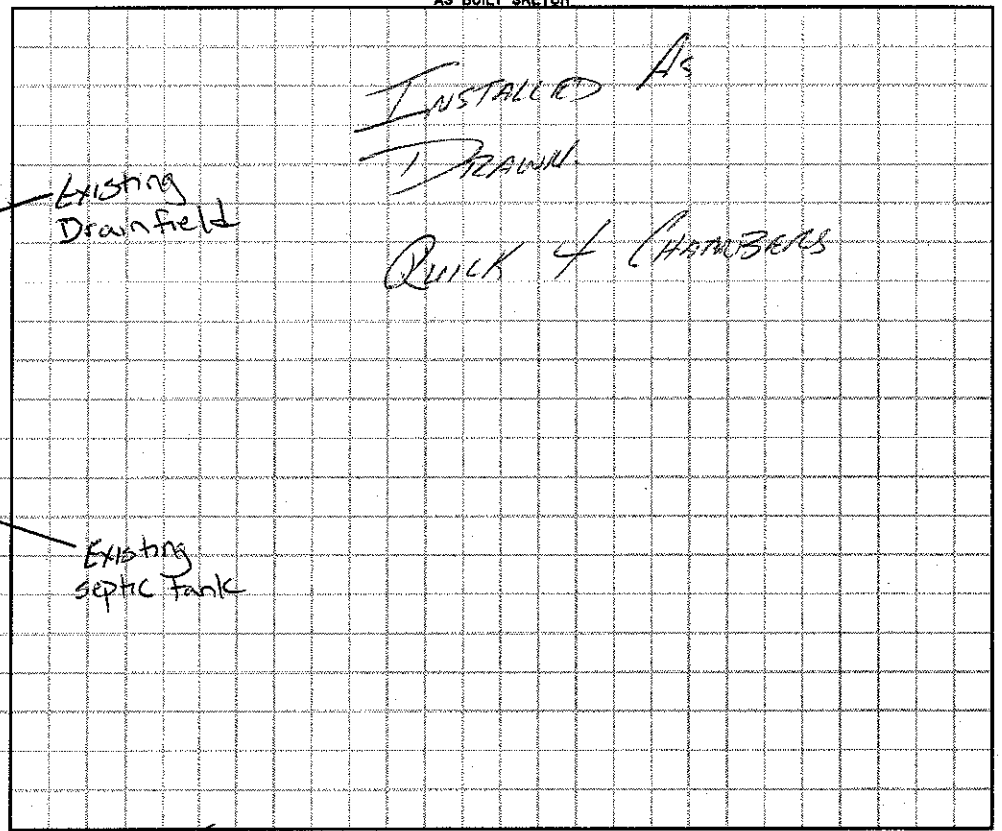

Permit can be suspended or revoked if any false information is supplied toward securing the permit / any unauthorized changes are made to the site / any unauthorized changes are made in the installation of the system. **CONTACT A LOCATOR SERVICE PRIOR TO ANY EXCAVATION**

☐ **IMPROVEMENT PERMIT** *with plat valid without expiration.* ☑ **IMPROVEMENT PERMIT** *with site plan valid for 60 mos.* ☑ **AUTHORIZATION TO CONSTRUCT** *valid for period equal to IMPROVEMENT PERMIT--not to exceed 60 mo.*

Owner / Applicant Signature: Larry Warren Date: 5-13-14 Installed by: A-1 Backhoe

IMPROVEMENT PERMIT by: Justin Henderson Date: 5-13-14 OPERATION PERMIT by: Date: 5/1/15

AUTHORIZATION TO CONSTRUCT by: Justin Henderson Date: 5-13-14 Existing System Inspected by: Date:

Health Dept. Copy - WHITE Applicant (Final Approval) - YELLOW Applicant (Conditional Approval) - PINK