IREDELL COUNTY HEALTH DEPARTMENT

STATESVILLE 704-878-5305 CJ MOORESVILLE 704-664-5281

IMPROVEMENT PERMIT / AUTHORIZATION TO CONSTRUCT / OPERATION PERMIT / EXISTING SYSTEM INSPECTION

PERMIT# 14827 PIN# 4731070972 DATE 3-4-08

OWNER OR APPLICANT AMERICA'S HOME PLACE INC PHONE: Business 704-746-7094 Home

ADDRESS 1206 Cervantes Drive Statesville NC 28677

LOCATION 21 SOUTH (R) ONTO (L) EASTMARD (R) WOOTTEN ON LEFT OFF ROAD

SUBDIVISION BLOCK / SECTION LOT LOT AREA 2.27AC SITE CLASS. PS DESIGN FLOW 480 L.T.A.R. .35

Septic Tank: 1000 Gallons: STB 1007 Date 2-13-08
Pump Tank: Gallons: PT Date
Pump Make: Model Serial No.
Nitrification Field: No Fields 1 Square Feet 660=1320 Linear Feet 343'
No Lines 6x57 Trench Width 36" Max Trench Bottom Depth 36" Gravel Depth N/A

☑ New System ☐ Repair ☐ Expansion System Type: I II (III) IV V VI
System Description: GRAVITY 25% Reduct
Repair System Description: Pump Conventional
Maintenance Agreement Required: ☐ Yes ☒ No

☒ House/Mod. Home ☐ Mobile Home ☐ Business ☐ Other
No. Bedrooms 4 No. Persons 8 No. Employees


Water Supply: ☒ Individual ☐ Public ☐ Community

☐ Slab ☐ Crawl Space ☒ Basement w/plumbing ☐ Basement wo/plumbing


Comments:/Conditions:
(1) INSTALL DRAW LINES AT 36" DEEP.
(2) KEEP WELL 100' DUE TO SAPROLITE
(3) Install Lines on Contours & MAINTAIN SETBACKS.
354'

Comments:/Conditions:
(4) House & Septic FLAGGED completely
(5) MET BUILDER: FAUCEN IN 18" OF BASEMENT GRADE OUT & Then FLAGGED IN SYSTEM; (6) SYSTEM SIZED FOR 4 BEDROOM: ONLY PLACING ON A 3 BEDROOM;

INITIAL SITE SKETCH

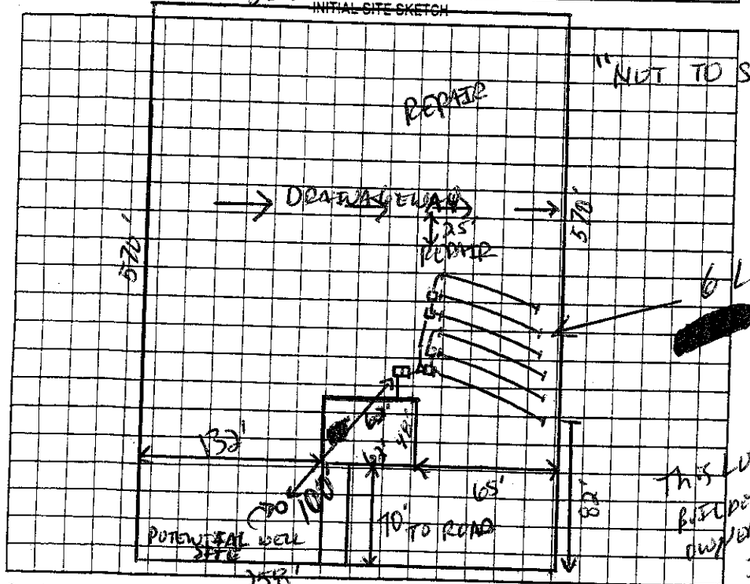

AS BUILT SKETCH

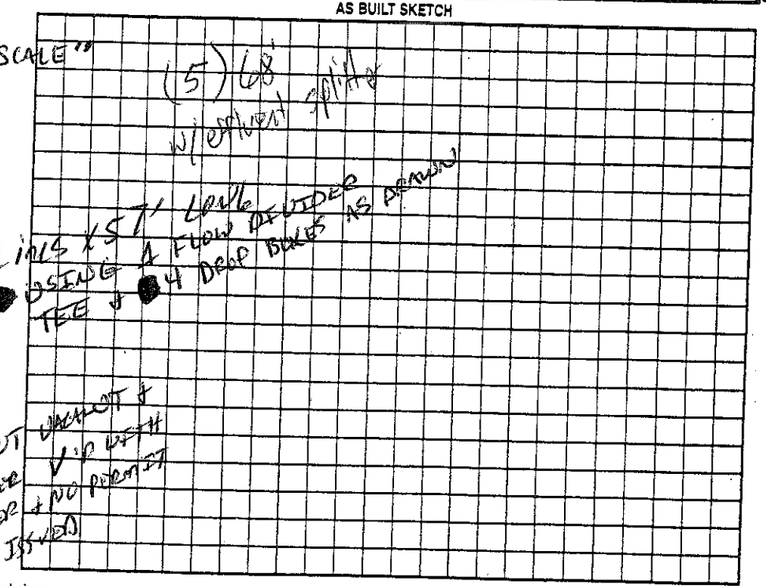

Permit can be suspended or revoked if any false information is supplied toward securing the permit/any unauthorized changes are made to the site/any unauthorized changes are made in the installation of the system. Improvement Permit with plat valid without expiration ☐ Improvement Permit with site plan valid for sixty months ☒ Authorization to Construct is valid for a period equal to that of Improvement Permit – not to exceed sixty months.

Signed: Chad Holly date 3/4/08
Improvement Permit by: date 3-4-08
Authorization to Construct by: date 3-4-08
Installed by: K & M Construction
Operation Permit by: date 4-15-08
Existing System Inspection by: date

HEALTH DEPT. COPY: WHITE OWNER COPY (FINAL): YELLOW OWNER COPY (INITIAL): PINK