IREDELL COUNTY HEALTH DEPARTMENT - *ENVIRONMENTAL HEALTH* ☑ STATESVILLE OFFICE 704-878-5305 ☐ MOORESVILLE OFFICE 704-664-5281

IMPROVEMENT PERMIT / AUTHORIZATION TO CONSTRUCT / OPERATION PERMIT / EXISTING SYSTEM INSPECTION

PERMIT # 163382 PIN # 4131-07-3951 DATE 20 October 10

OWNER John Martin APPLICANT: America's Home Place PHONE: Home/Cell # Business # (704) 746-7094

SITE ADDRESS Wootie Drive Statesville OWNER / APPLICANT ADDRESS 452 Faith Rd. Mooresville

SITE DIRECTIONS cold mtn. Rd Turn onto East Monbo & TR Wootie Dr. lot on left.

SUBDIVISION BLOCK / SECTION LOT # LOT AREA 2.27ac. DESIGN FLOW 360g/d. L.T.A.R. 0.3g/ft²/d

Septic Tank 1000 Gallons: STB 1012 Date 3-18-10
Pump Tank Gallons: P T Date
Pump Make Model Serial #
No. Nitrification Fields: 1 No. Lines 3 Linear Feet 300.
Trench Width 36" Max. Trench Bottom Depth 36" Gravel Depth NA

☑ New System ☐ Repair ☐ Expansion System Type I II (III) IV V VI
System Description: 25% Reduction
Repair System Description: 25% Reduction
Maintenance Agreement Required ☐ YES ☒ NO
☑ GRAVITY ☐ PRESSURE


☑ Residence No. Bedrooms 3
☐ Business No. Persons
☐ Other No. Employees
☐ Slab ☑ Crawl Space
☐ Basement w/plumbing ☐ Basement w/o plumbing

Water Supply: ☑ Private ☐ Public ☐ Community


Comments / Conditions: Keep out of road rt-of-way / Clear trees as required for proper installation of system.

ST Has marker
Pol-lock Filter tee

INITIAL SITE SKETCH

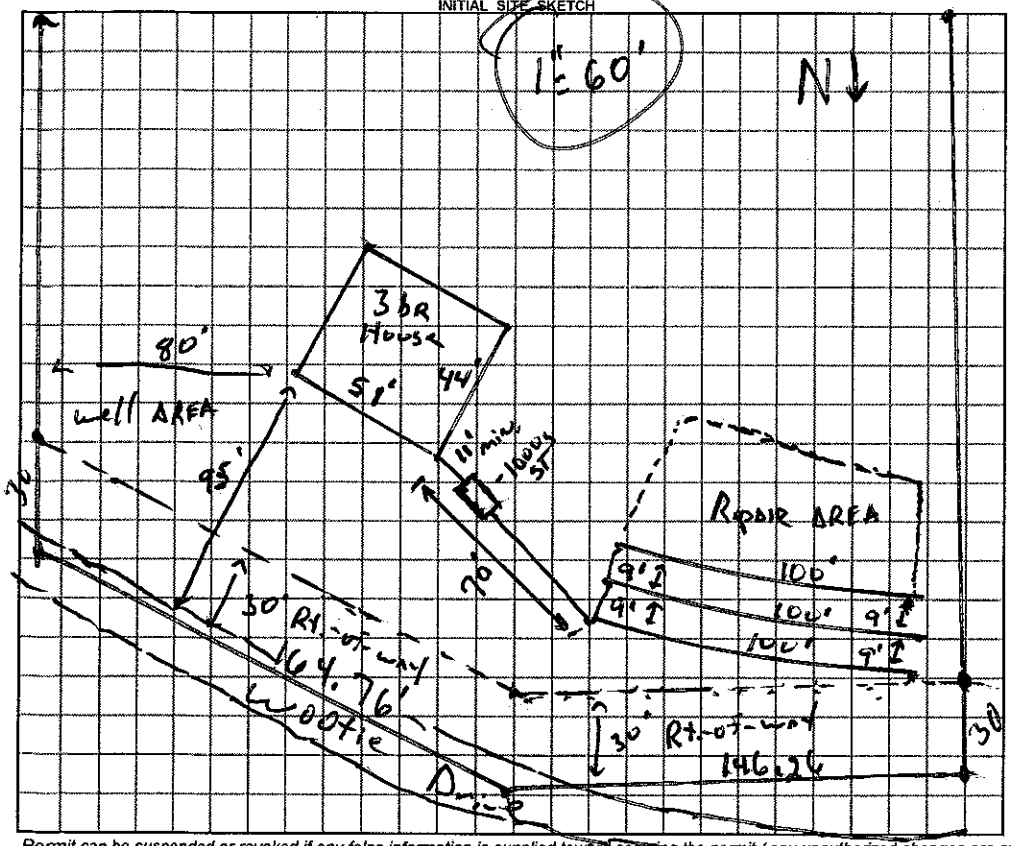

AS BUILT SKETCH

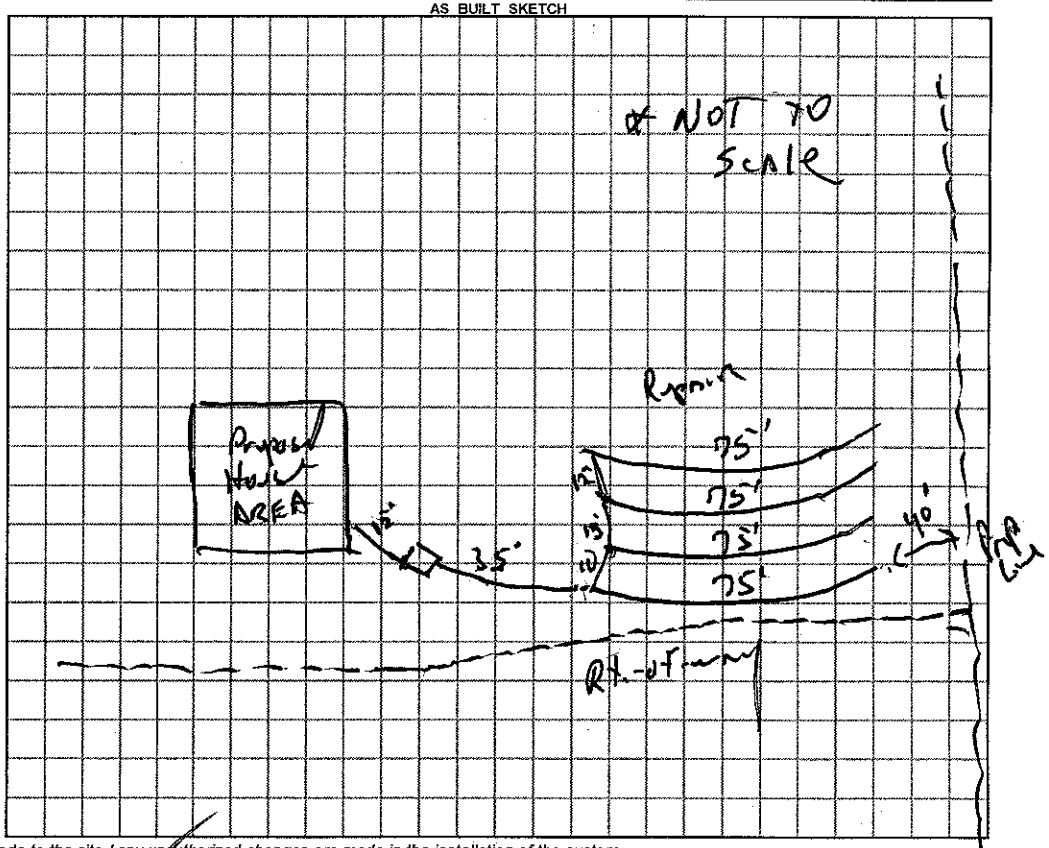

Permit can be suspended or revoked if any false information is supplied toward securing the permit / any unauthorized changes are made to the site / any unauthorized changes are made in the installation of the system.

☐ ***IMPROVEMENT PERMIT*** with plat valid without expiration.

☑ ***IMPROVEMENT PERMIT*** with ~~plat~~ site plan valid without expiration for 60 mo.

☑ ***AUTHORIZATION TO CONSTRUCT*** valid for period equal to IMPROVEMENT PERMIT--not to exceed 60 mo.

Owner / Applicant Signature: Date 10/21/10 Installed by: Groundbreakers

IMPROVEMENT PERMIT by: R.S. REHS Date 20 Oct. 10 OPERATION PERMIT by: REHS Date 5 November 10

AUTHORIZATION TO CONSTRUCT by: R.S. REHS Date 20 Oct. 10 Existing System Inspected by: REHS Date

YOU SHOULD CONTACT A LOCATOR SERVICE PRIOR TO ANY EXCAVATION

White Copy – Environmental Health YELLOW COPY (Final) Owner / Applicant PINK COPY (Initial) Owner / Applicant