Called In

IREDELL COUNTY HEALTH DEPARTMENT

STATESVILLE 704-878-5305 CI MOORESVILLE 704-664-5281

IMPROVEMENT PERMIT / AUTHORIZATION TO CONSTRUCT / OPERATION PERMIT / EXISTING SYSTEM INSPECTION

PERMIT# 132073 PIN# 4731 08 4327 DATE 11-9-05

OWNER OR CONTRACTOR Jerry Harmon PHONE: Business Home 336 492-5855

ADDRESS Wootie Dr. Statesville

LOCATION Old Mountain Rd. (L) E. Monbo South. (R) Wootie - property on (R)

SUBDIVISION n/a BLOCK / SECTION LOT LOT AREA SITE CLASS. III DESIGN FLOW 360 L.T.A.R. .3

Septic Tank: 1000 Gallons; STB TP 1012 Date 4-9-05

Pump Tank: Gallons; PT Date

Pump Make: Model Serial No.

Nitrification Field: No Fields 1 Square Feet 1200 Linear Feet 300

No Lines 4 Trench Width 3 Max Trench Bottom Depth 36 Gravel Depth

[X] New System [ ] Repair System Type: I II III IV V VI

System Description: 25% Reduction - Gravity

Repair System Description: 25% Reduction - Gravity

Maintenance Agreement Required: [ ] Yes [X] No

[X] House/Mod. Home No. Bedrooms 3

[ ] Mobile Home No. Bathrooms

[ ] Business No. Employees

[ ] Other

[ ] Slab [X] Crawl Space [ ] Basement w/plumbing [ ] Basement wo/plumbing

Water Supply: [X] Individual [ ] Public [ ] Community


Comments:/Conditions:

Comments:/Conditions:


Yellow Filter

Septic Marker

INITIAL SITE SKETCH

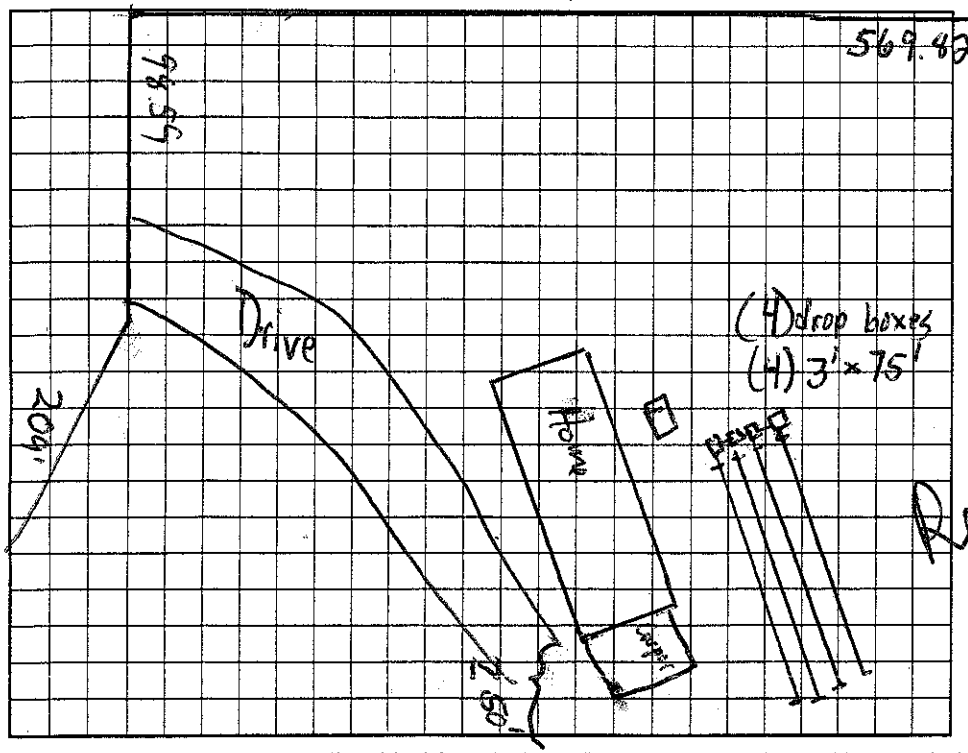

AS BUILT SKETCH

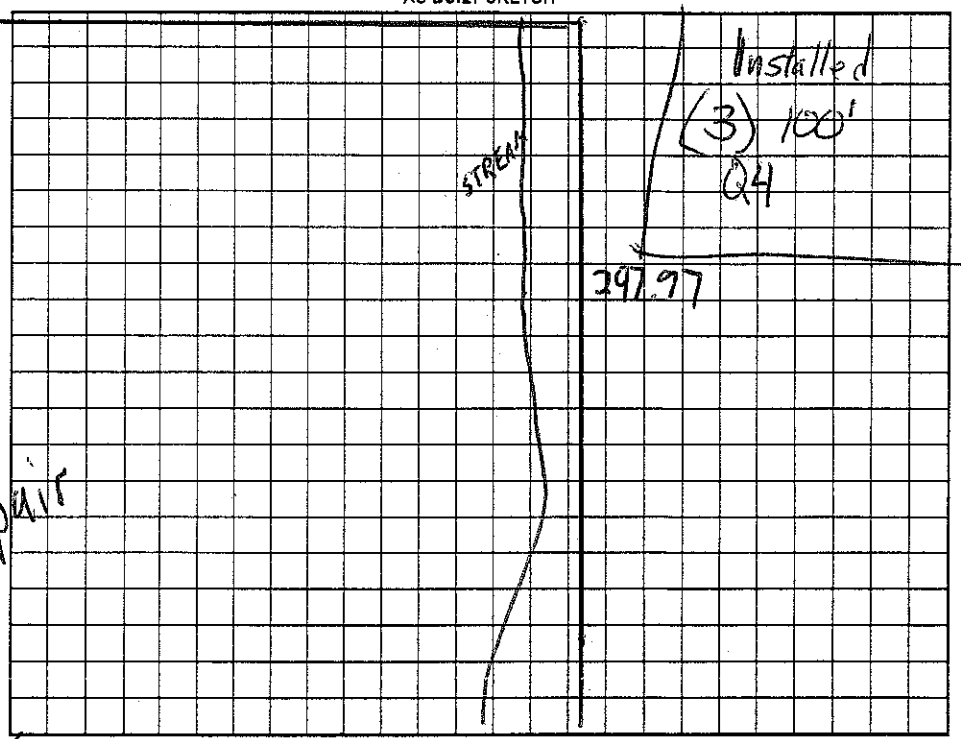

Permit can be suspended or revoked if any false information is supplied toward securing the permit/any unauthorized changes are made to the site/any unauthorized changes are made in the installation of the system. Improvement Permit with plat valid without expiration. Improvement Permit with site plan valid for sixty months. Authorization to Construct is valid for a period equal to that of Improvement Permit – not to exceed sixty months.

Signed: Deanna Gallihar date 11-9-05 Installed by: A-1 Backhoe

Improvement Permit by: James Stevens date 11-9-05 Operation Permit by: James Stevens date 11-18-05

Authorization to Construct by: James Stevens date 11-9-05 Existing System Inspection by: date

HEALTH DEPT. COPY: WHITE OWNER COPY (FINAL): YELLOW OWNER COPY (INITIAL): PINK