47501

IREDELL COUNTY HEALTH DEPARTMENT

STATESVILLE 704-878-5305 MOORESVILLE 704-664-5281

IMPROVEMENT PERMIT / CERTIFICATE OF COMPLETION / OPERATION PERMIT / EXISTING SYSTEM INSPECTION

PROPERTY DESCRIPTION NO. Town of Troutman DATE 6-8-93 TAX MAP NO. 3K B28B

OWNER OR CONTRACTOR Jack Turney PHONE: Business _____ Home 663-2008

ADDRESS _____

LOCATION From Troutman take Old Mtn. Rd. TL East Mombo Rd. Lot on L acress from Saddle Brook Farms.

SUBDIVISION NA BLOCK / SECTION _____ LOT _____ LOT AREA 1.144 acres SITE CLASS. P.S. L.T.A.R. .35 gpd/ft²

Water Supply: ☑ Individual ☐ Community ☐ Public Well

Septic Tank: 1000 Gallons: STB 378 Date 2-8-93

Pump Tank: — Gallons: PT — Date —

Nitrification Field: No Fields 1 Square Feet 690 Linear Feet 230'

No Lines 3 Trench Width 36" Trench Depth 24"-30" Gravel Depth 12"

☑ New System ☐ Repair System Type: I. (II.) III. IV. V. VI

System Description: Conventional, gravity fed

Repair System Description: Pump to conventional

Maintenance Agreement Required: ☐ Yes ☑ No

☐ House/Mod. Home ☑ Mobile Home ☐ Business ☐ Other

No. Bedrooms 2 No. Bathrooms 1 No. Employees —

Garbage Disposal: ☐ Yes ☑ No

Auto. Dishwasher: ☐ Yes ☐ No


Auto. Washing Machine: ☑ Yes ☐ No

Other _____


☐ Slab ☑ Crawl Space ☐ Basement w/plumbing ☐ Basement wo/plumbing

Comments 100% Repair above home, pump to conventional.

INITIAL SITE SKETCH

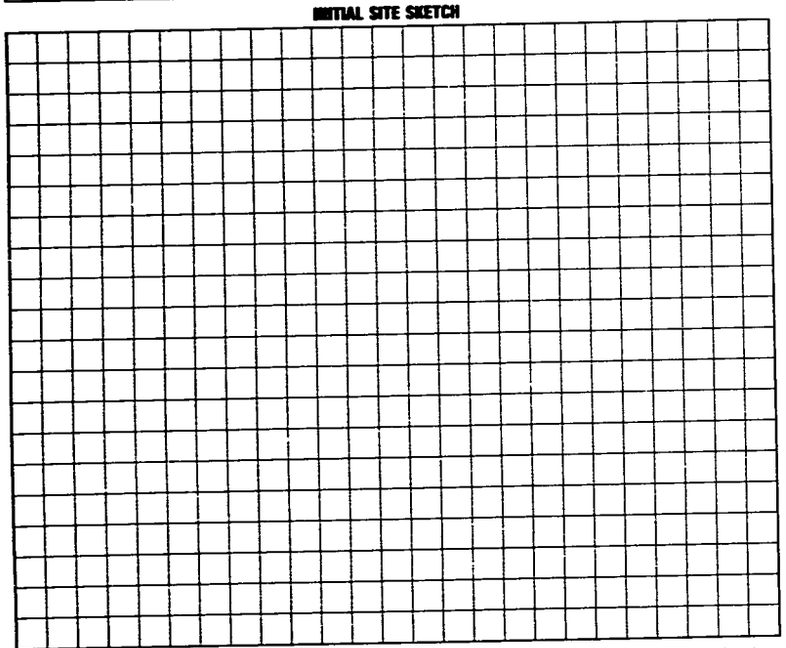

AS BUILT SKETCH

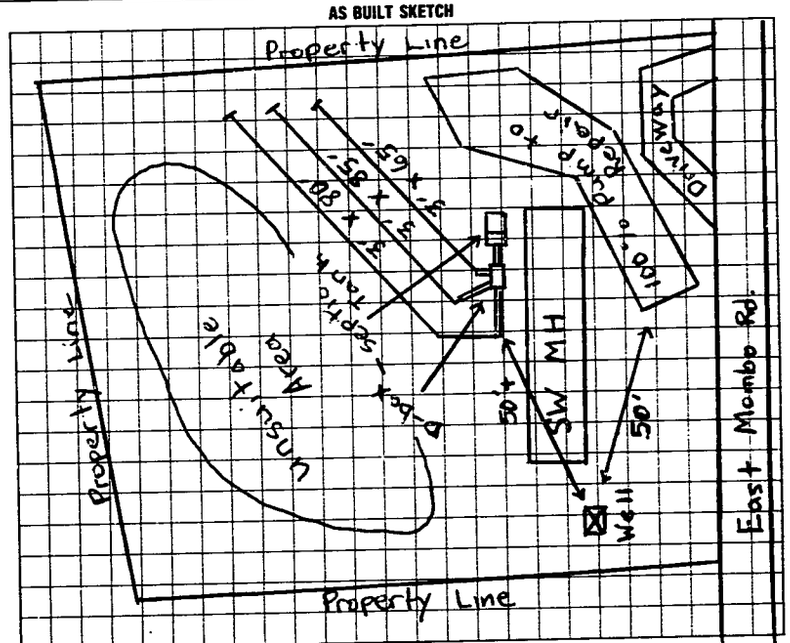

I understand that this permit can be suspended or revoked if any false information is supplied toward securing the permit/any unauthorized changes are made to the site/any unauthorized changes are made in the installation of the system. Improvement Permit is valid for 60 months from date of issuance.

Signed: _____

Improvement Permit by: Michael J. Dennis date 5-28-93

Existing System Inspection by: _____ date _____

Installed by: James Hudler

Certificate of Completion by: Michael J. Dennis date 6-8-93

Operation Permit by: _____ date _____

HEALTH DEPT. COPY: WHITE INSPECTION COPY (FINAL): GREEN OWNER COPY (FINAL): YELLOW INSPECTION COPY (INITIAL): PINK OWNER COPY (INITIAL): GOLD