# IREDELL COUNTY HEALTH DEPARTMENT

STATESVILLE 704-878-5305 MOORESVILLE 704-664-5281

## IMPROVEMENT PERMIT / AUTHORIZATION TO CONSTRUCT / OPERATION PERMIT / EXISTING SYSTEM INSPECTION

PERMIT# REPAIR PIN# 4731-17-8148 DATE 3-8-02

OWNER OR CONTRACTOR JOHN ALLEN COLLINS PHONE: Business Home 704-528-5613

ADDRESS 365 EAST MONBO ROAD, STATESVILLE, NC 28677

LOCATION OLD MOUNTAIN ROAD TO EAST MONBO ROAD 1.0 MILE ON LEFT

SUBDIVISION BLOCK / SECTION LOT LOT AREA 13.59 ACRES SITE CLASS. PS DESIGN FLOW 360 L.T.A.R. EXISTING

Septic Tank: EXISTING Gallons: STB Date

Pump Tank: Gallons: PT Date

Pump Make: Model Serial No.

Nitrification Field: No Fields 1 Square Feet 450 Linear Feet 150

No Lines TWO Trench Width 36" Max Trench Bottom Depth 36"

☐ New System ☑ Repair System Type: I (II) III IV V VI

System Description: CONVENTIONAL, GRAVITY

Repair System Description: CONVENTIONAL, GRAVITY

Maintenance Agreement Required: ☐ Yes ☑ No

Gravel Depth 12" ☐ Slab ☐ Crawl Space ☑ Basement w/plumbing ☐ Basement wo/plumbing

☑ House/Mod. Home No. Bedrooms 3

☐ Mobile Home No. Bathrooms 3

☐ Business No. Employees

☐ Other


Water Supply: ☑ Individual ☐ Public ☐ Community

WELL

Comments:/Conditions: INSTALL NEW DISTRIBUTION BOX IN EXISTING DRAINFIELD FEEDING TWO NEW 3' x 75' LINES AS SHALLOW AS POSSIBLE; PUMP OUT SEPTIC TANK & CLEAN OUT ROOTS

Comments:/Conditions: USE 2 POUNDS COPPER SULFATE ANNUALLY TO RESTRICT ROOT GROWTH (2) TIE WASHER DRAIN INTO SEPTIC TANK

INITIAL SITE SKETCH

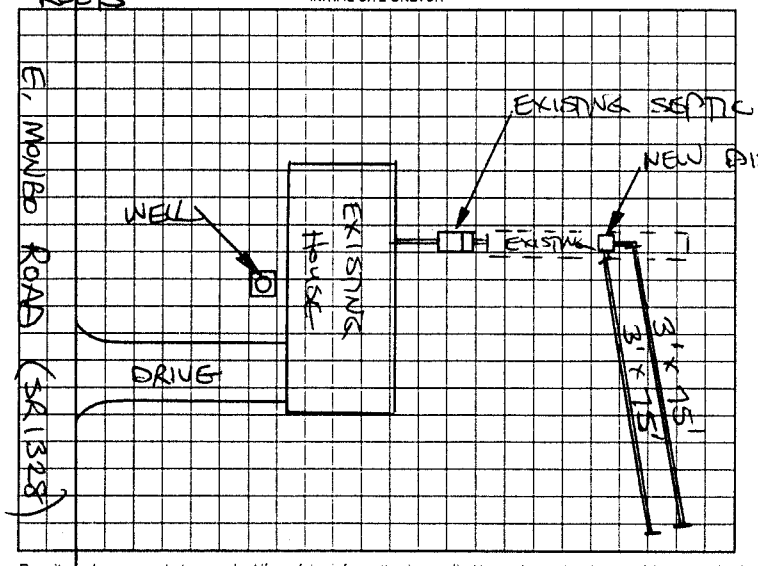


AS BUILT SKETCH

SYSTEM REPAIRED ACCORDING TO INITIAL SITE SKETCH

Permit can be suspended or revoked if any false information is supplied toward securing the permit/any unauthorized changes are made to the site/any unauthorized changes are made in the installation of the system. Improvement Permit with plat valid without expiration. Improvement Permit with site plan valid for sixty months. Authprization to Construct is valid for a period equal to that of Improvement Permit – not to exceed sixty months.

Signed: [signature] date 3/8/02 Installed by: WES LYTTON

Improvement Permit by: STEVE HEDRICK date 3-8-02 Operation Permit by: STEVE HEDRICK date 3-26-02

Authorization to Construct by: STEVE HEDRICK date 3-8-02 Existing System Inspection by: date

HEALTH DEPT COPY WHITE OWNER COPY (FINAL) YELLOW OWNER COPY (INITIAL) PINK