IREDELL COUNTY HEALTH DEPARTMENT

Statesville Office (704) 878-5305 Mooresville Office (704) 660-3625 PERMIT # 216276

IMPROVEMENT PERMIT / AUTHORIZATION TO CONSTRUCT / OPERATION PERMIT / EXISTING SYSTEM

PIN # 4731178148

APPLICANT: John Allen Collins APPLICANT ADDRESS: 365 E. Monbo Rd Statesville NC

SITE ADDRESS: 365 E. Monbo Rd Statesville NC PHONE: 704-528-5613 ALT. PHONE: N/A

SITE DIRECTIONS: 21 S T/R old Mtn Rd T/L E Monbo Rd Lot on left

SUBDIVISION: N/A SECTION: N/A LOT # N/A LOT AREA: 13.59 ac DESIGN FLOW: Ex L.T.A.R.: Ex

Septic Tank	Ex	(gal)	STB		Date				
Pump Tank		(gal)	PT		Date				
Pump Make			Model		Serial #				
# Nitrification Fields	Ex	# Lines	Ex	Linear Ft:	Ex				
Trench Width	Ex	Max. Trench Bottom Depth	Ex	Gravel Depth	Ex				

☐ New System ☐ Repair ☐ Expansion System Type: I ☒ III IV V VI

System Description: Existing

Repair System Description:

Maintenance Agreement Required: ☐ YES ☒ NO

☒ GRAVITY ☐ PRESSURE

☒ Residence No. Bedrooms Ex

☐ Business No. Persons Ex

☐ Other No. Employees

☐ Slab ☐ Crawl Space

☒ Basement w/plumbing ☐ Basement w/o plumbing

Water Supply


☒ Private

☐ Public

☐ Community


Comments / Conditions: All building foundations must be 35' from any part of STS

INITIAL SITE SKETCH

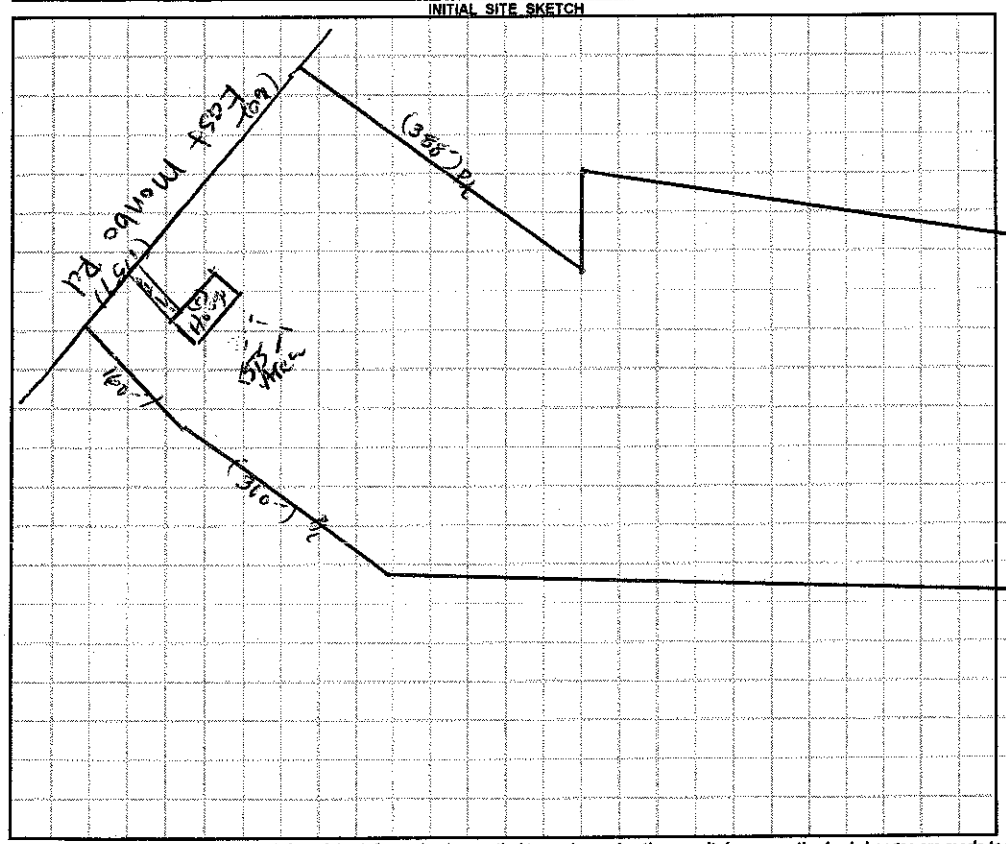

AS BUILT SKETCH

1"=200

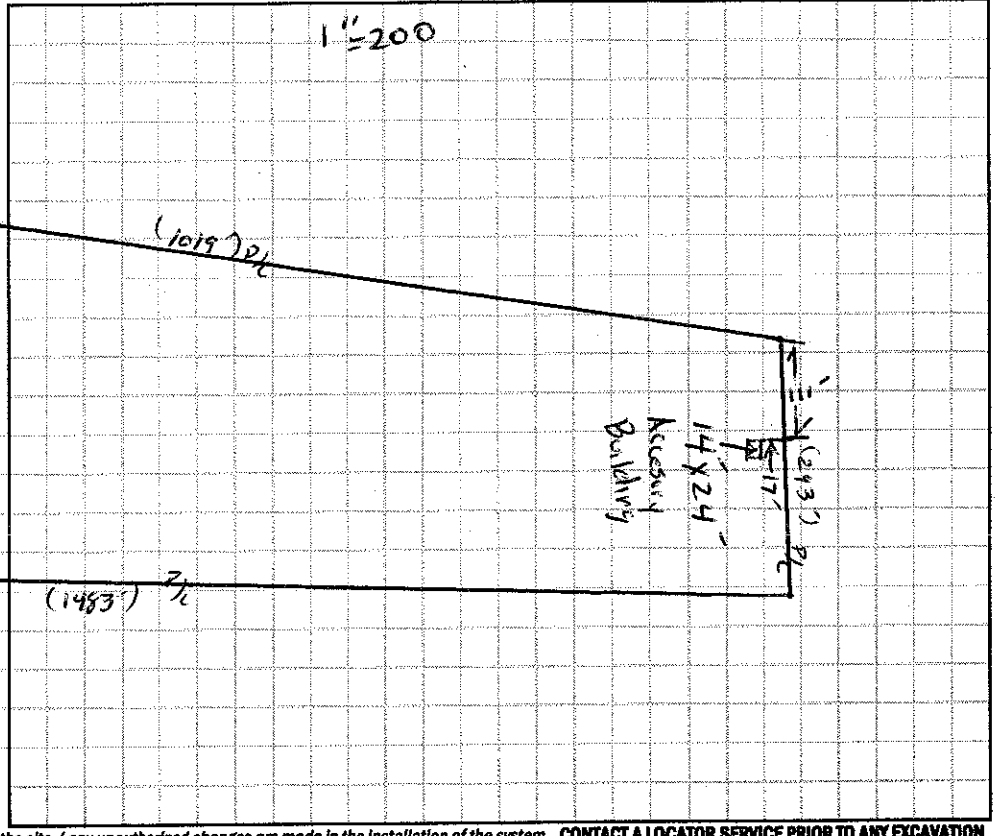

Permit can be suspended or revoked if any false information is supplied toward securing the permit / any unauthorized changes are made to the site / any unauthorized changes are made in the installation of the system. **CONTACT A LOCATOR SERVICE PRIOR TO ANY EXCAVATION**

☐ **IMPROVEMENT PERMIT** *with plat valid without expiration.* ☐ **IMPROVEMENT PERMIT** *with site plan valid for 60 mos.* ☐ **AUTHORIZATION TO CONSTRUCT** *valid for period equal to IMPROVEMENT PERMIT--not to exceed 60 mo.*

Owner / Applicant Signature: John Allen Collins Date: Installed by:

IMPROVEMENT PERMIT by: Date: OPERATION PERMIT by: Date:

AUTHORIZATION TO CONSTRUCT by: Date: Existing System Inspected by: Date: 02/10/16

Health Dept. Copy - WHITE Applicant (Final Approval) - YELLOW Applicant (Conditional Approval) - PINK