IREDELL COUNTY HEALTH DEPARTMENT

STATESVILLE 704-878-5305 (ad) MOORESVILLE 704-664-5281

IMPROVEMENT PERMIT / AUTHORIZATION TO CONSTRUCT / OPERATION PERMIT / EXISTING SYSTEM INSPECTION

PERMIT# 143998 PIN# 4731187145

OWNER OR APPLICANT Julie Breedlove PHONE: Business 704 661 9619 Home 704 528 4131 DATE 10/5/07

ADDRESS 330 E. Monbo

LOCATION Hwy 21 to Old Mth. Rd (L) E. Monbo 3/4 mile on Right

SUBDIVISION n/a BLOCK / SECTION ____ LOT ____ LOT AREA 13.92 SITE CLASS. PS DESIGN FLOW 360 480 L.T.A.R. .25

Septic Tank: 1000 Gallons: STB 194 Date 8-26-07

Pump Tank: ____ Gallons: PT ____ Date ____

Pump Make: ____ Model ____ Serial No. 360 ?

Nitrification Field: No Fields 1 Square Feet 1920 Linear Feet 480

No Lines 4 3 Trench Width 36" Max Trench Bottom Depth 36

☒ New System ☐ Repair ☐ Expansion System Type: I II III IV V VI

System Description: 25% Reduction Gravity

Repair System Description: 25% Reduction Gravity

Maintenance Agreement Required: ☐ Yes ☒ No

Gravel Depth n/a ☒ Gravity ☐ Pressure ☐ Slab ☒ Crawl Space ☐ Basement w/plumbing ☐ Basement wo/plumbing

☒ House/Mod. Home ☐ Mobile Home ☐ Business ☐ Other

No. Bedrooms 4 3 No. Persons 3 No. Employees ____


Water Supply: ☒ Individual ☐ Public ☐ Community

Comments:/Conditions:

(4) 3'×120'

* if 3 Bedrooms then (3) 3'×120'

INITIAL SITE SKETCH

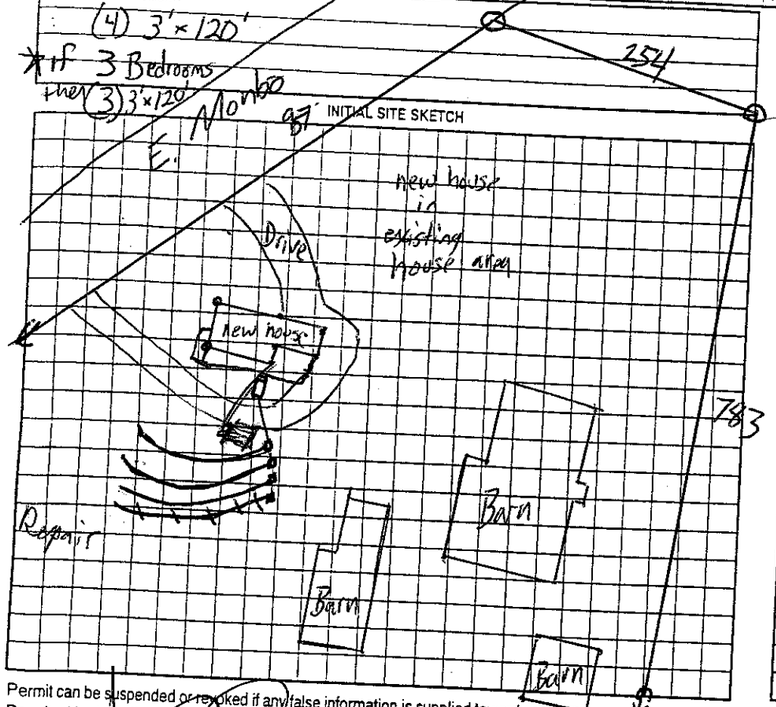

Comments:/Conditions:

$ 7-18-08

AS BUILT SKETCH

On 7-15 R&H Septic called and informed that the homeowner stated house is a 3 BR not 4, and instructed the installer to remove 4th line after inspection.

- Linear feet, design flow, bedroom, line numbers changed on permit 7-18-08 by

The proposed porch - hot tub addition does not appear to impact the existing septic system.

**NOTE: ____

Date: 9-3-09 R.S.

ICHD-Environmental Health Division

Permit can be suspended or revoked if any false information is supplied toward securing the permit/any unauthorized changes are made to the site/any unauthorized changes are made in the installation of the system. Improvement Permit with plat valid without expiration ☐ Improvement Permit with site plan valid for sixty months ☒ Authorization to Construct is valid for a period equal to that of Improvement Permit – not to exceed sixty months.

Signed: ____ date 10/8/07

Improvement Permit by: ____ date 10/5/07

Authorization to Construct by: ____ date 10/5/07

Installed by: R&H Septic Lake Norman

Operation Permit by: ____ date 7-3-08

Existing System Inspection by: ____ date ____

HEALTH DEPT. COPY: WHITE OWNER COPY (FINAL): YELLOW OWNER COPY (INITIAL): PINK