IREDELL COUNTY HEALTH DEPARTMENT

Application For Improvement Permit and/or Authorization To Construct, Existing System Inspection

(THE ABOVE PERMIT DOCUMENTS WILL BECOME INVALID IF INFORMATION PROVIDED ON THIS APPLICATION IS FALSIFIED OR CHANGED, OR IF THE SITE IS ALTERED. THE IMPROVEMENT PERMIT IS VALID FOR EITHER 60 MONTHS OR WITHOUT EXPIRATION DEPENDING UPON DOCUMENTATION SUBMITTED - APPLICATION WITH SITE PLAN 60 MONTHS, APPLICATION WITH COMPLETE, SCALED PLAT WITHOUT EXPIRATION. SEE 15A NCAC 18A .1937(f) FOR DETAILS)

1. APPLICATION FOR: ___ Improvement Permit ___Authorization To Construct ___BOTH X Existing System Inspection

2. Page 2: *Site Plan Worksheet* Form MUST Accompany This Application
   The following optional attachments may also be submitted:
   Place check ( ) beside whichever is submitted if applicable
   ___ Survey Plat, Scaled no more than 1 Inch = 60 Feet
   ___ Custom Site Plan, Scaled no more than 1 Inch = 60 Feet

3. **Applicant Information:**

Applicant Name	Mailing Address	Home Phone	Work Phone
Julie Breedlove	330 E Monbo Rd	7045284131	7046619619
Owner Name	Mailing Address	Home Phone	Work Phone

4. **Property Information:**

330 E Monbo Rd — Street Address
N/A — Subdivision Name
PIN 4731187145 — Section/Phase and Lot Number

Driving Directions: Hwy 21 old Mt ① east monbo 1 mile on R

****

5. **RESIDENTIAL Site Development Information:** *(Check or Complete ALL that apply)*

( ) New, Single Family Residence
( ) New, Multi-Family Residence
( ) Expansion of Existing Septic System
( ) Repair To Failing Septic System

Maximum Number of Bedrooms ___
Maximum Number of Occupants ___
If Expansion, Current Number of Bedrooms ___

( ) Crawl Space Foundation?
( ) Concrete Slab Foundation?
( ) Basement w/Plumbing?
( ) Basement w/out Plumbing?

IF Non-Residential Site Development:
Type of Business
Square Footage ~~of Building~~ Deck — 950 SF ~~- 1,000 SF~~
Maximum Number of Employees
Maximum Number of Seats

****

6. **Proposed Water Supply:**

( ) New Well ( ) Existing Well ( ) Community Well ( ) City Water (✓) Other Public Water — Boutman

****

7. **Desired Septic System Type:** *(You may rank in order of preference, if any)*

( ) Alternative (✓) Conventional ( ) Innovative ( ) Modified Conventional ( ) Other_____ ( ) No Preference

****

8. **Please Answer The Following To The Best of Your Ability:**

( ) Yes (✓) No Does the site contain any jurisdictional wetlands?
( ) Yes (✓) No Is any non-domestic sewage (i.e. industry) to be generated?
( ) Yes (✓) No Is the site subject to approval by any other public agency?

****

I have read this application and certify that the information provided herein is true, complete, and correct. Authorized county and state officials are granted right of entry to conduct necessary inspections to determine compliance with applicable laws and rules. I understand that I am solely responsible for the proper identification and labeling of all property lines and corners and making the site accessible so that a complete site evaluation can be performed.

9. Signature Julie R Breedlove
Property owner or owner's legal representative signature (SIGNATURE REQUIRED)

9/8/09
DATE

IREDELL COUNTY HEATLH DEPARTMENT

PAGE 2: *SITE PLAN WORKSHEET*

SEE THE SAMPLE SITE PLAN BELOW. INCOMPLETE SITE PLANS WILL BE RETURNED TO YOU FOR COMPLETION AND MAY RESULT IN A DELAY IN THE ISSUANCE OF YOUR SEPTIC SYSTEM PERMIT!!!

Place an (X) beside each item as you complete the site plan:

____ **Property Line measurements are clearly identified…**
____ **All proposed structures are indicated…**
SHOW: proposed house or business footprint, wells, water lines, patios, pools and decks, and any other item that will occupy space on the site
____ **Front and side setbacks from property line…**
____ **Preferred driveway location and configuration, preferred well location…**
____ **Area you prefer your septic system to be placed…**
____ **North arrow, or other sufficient indicator of direction…**

Circle N/A on the following if appropriate:


____ **Location of septic systems and wells within 100' of your property…** **N/A**
____ **Location of easements and rights of ways on your property…** **N/A**
____ **Location of any designated wetlands on the property…** **N/A**


Signature: Julie R Bradley
Property owner or owner's legal representative signature (SIGNATURE REQUIRED)

9/8/09
DATE

USE THIS SPACE TO DRAW YOUR SITE PLAN

See attached

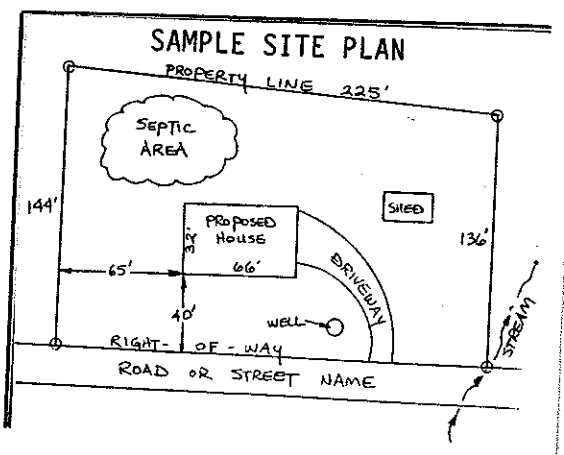

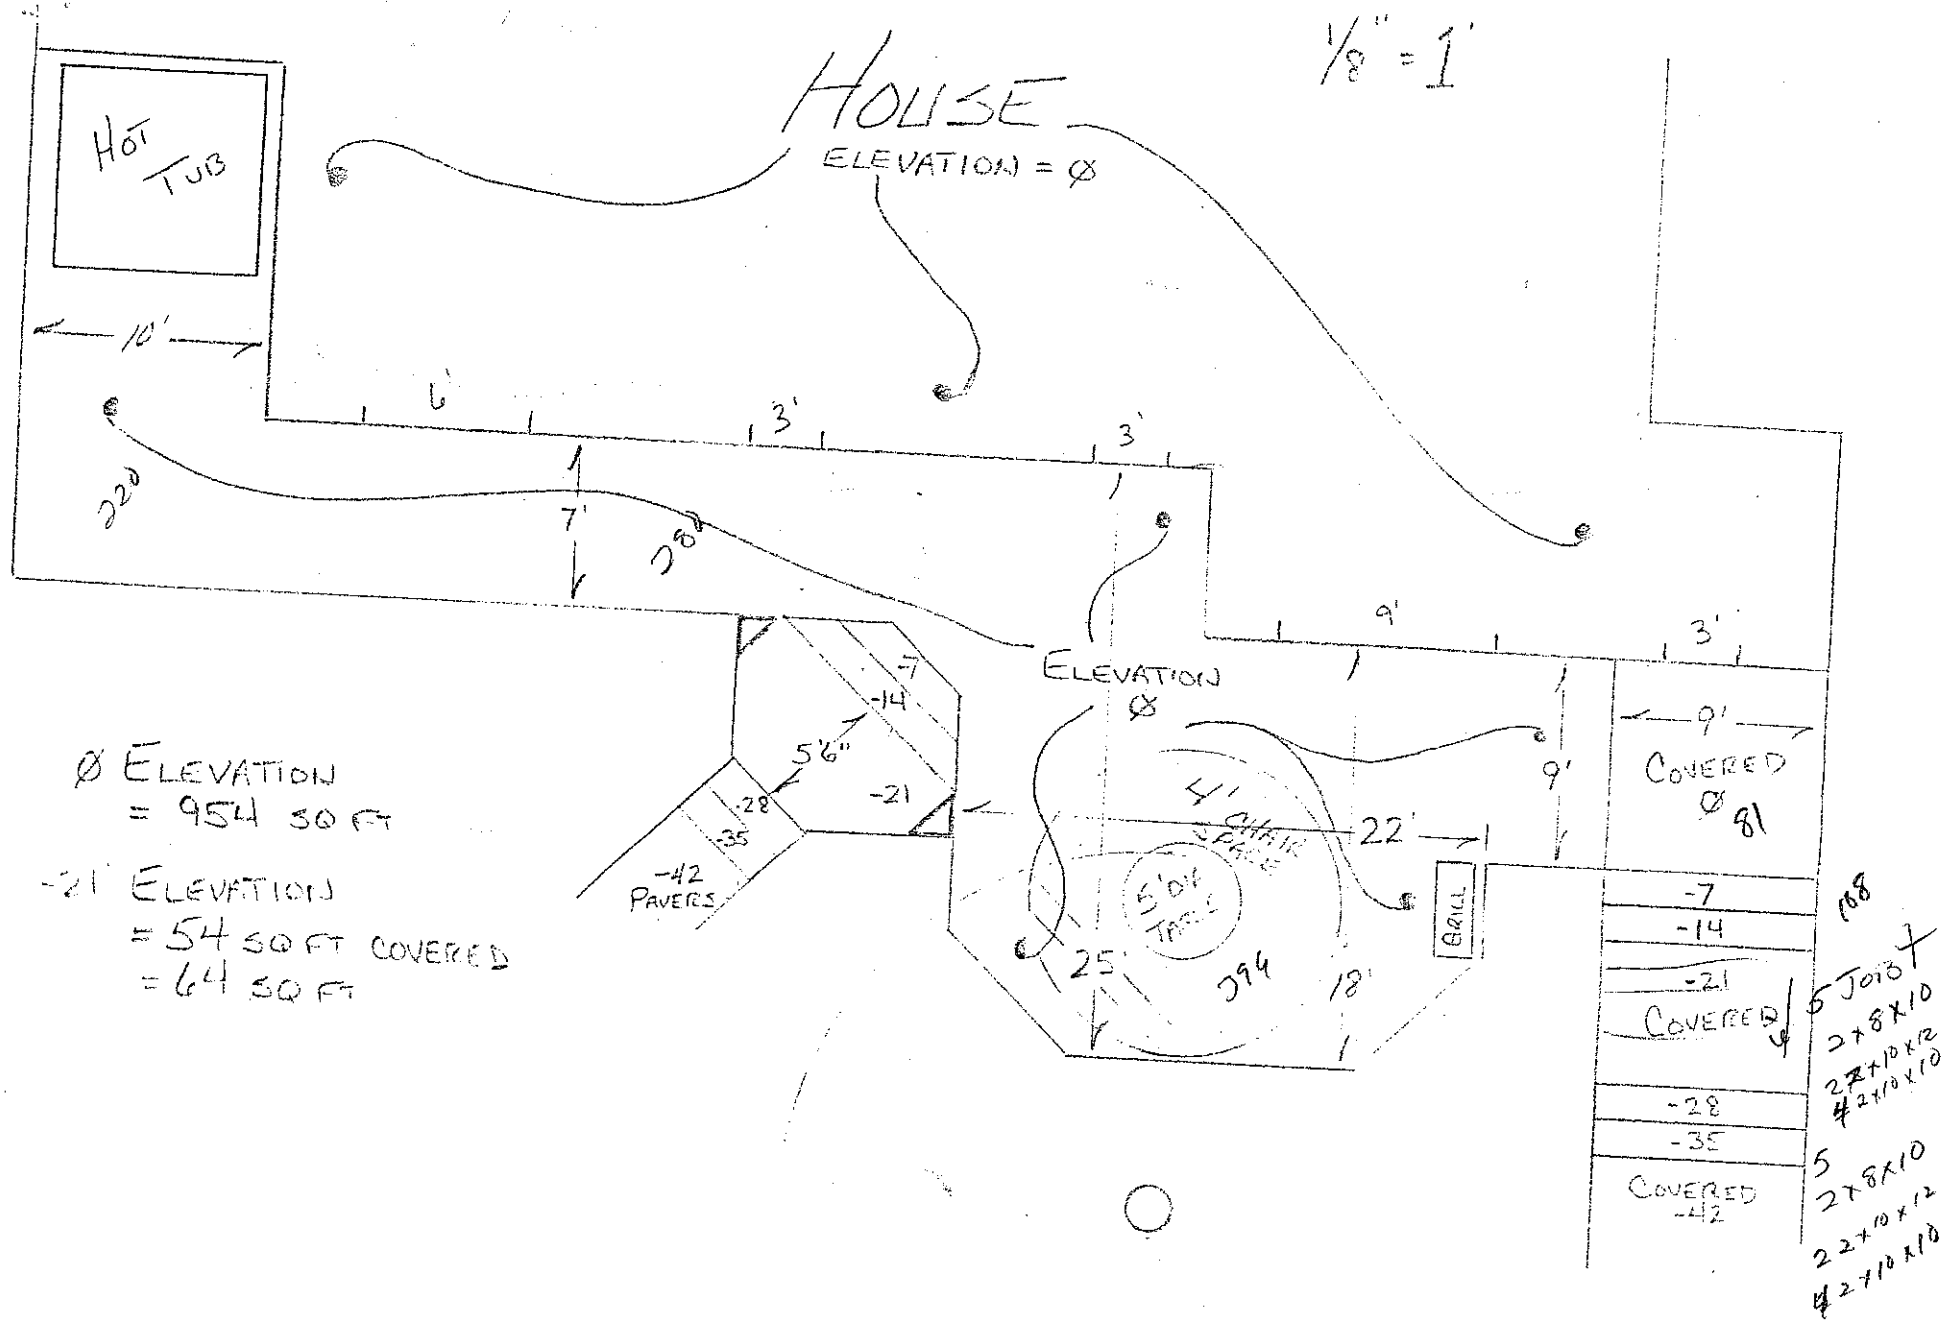
HOUSE
ELEVATION = Ø
1/8" = 1'
HOT TUB
10'
6'
3'
3'
32°
7'
38°
9'
3'
ELEVATION Ø
-7
-14
-21
-28
-35
-42
PAVERS
5'6"
22'
9'
9'
COVERED Ø 81
-7
-14
-21
COVERED
-28
-35
COVERED -42
5'0" TABLE
25'
18'
394
GRILL
108
5 JOIST 2x8x10
2x10x12
4 2x10x10
5 2x8x10
2x10x12
4 2x10x10
Ø ELEVATION
= 954 SQ FT
-21' ELEVATION
= 54 SQ FT COVERED
= 64 SQ FT