12551

This permit voids previously issued permit dated 3/18/04.

IREDELL COUNTY HEALTH DEPARTMENT

STATESVILLE 704-878-5305 (C) MOORESVILLE 704-664-5281

IMPROVEMENT PERMIT / AUTHORIZATION TO CONSTRUCT / OPERATION PERMIT / EXISTING SYSTEM INSPECTION

PERMIT# City of Troutman PIN# 4731-22-2099 DATE 8/31/04

OWNER OR CONTRACTOR Gerald Tom Adley Jr. PHONE: Business — Home (704) 661-1863

ADDRESS [redacted] 240 Lytton St, Troutman N.C. 28166

LOCATION Hwy 21 S, (R) Talley Road, ½ mile on left past Lytton Farm Rd (across from S/W MH) about .3 mile off road

SUBDIVISION — BLOCK / SECTION — LOT — LOT AREA 4.8 Ac SITE CLASS. PS DESIGN FLOW 480 L.T.A.R. .25 gpd

Site Address: 142 Talley Ridge Dr.

Septic Tank: 1,000 Gallons; STB 1012 Date 9-19-04

Pump Tank: — Gallons; PT — Date —

Pump Make: — Model — Serial No. 345

Nitrification Field: ~~Trench~~ Beds 1 Square Feet 1372 Linear Feet ~~460~~

No Lines ~~4 Lines~~ Trench Width 36" Max Trench Bottom Depth 28" Gravel Depth 12"

☒ New System ☐ Repair System Type: I, II, III, IV, V, VI

System Description: Gravity Conventional

Repair System Description: Pump 25% Reduction

Maintenance Agreement Required: ☐ Yes ☒ No

☒ House/Mod. Home No. Bedrooms 4

☐ Mobile Home No. Bathrooms —

☐ Business No. Employees —

☐ Other —


☐ Slab ☐ Crawl Space ☒ Basement w/plumbing ☐ Basement wo/plumbing

Water Supply: ☒ Individual ☐ Public ☐ Community


Comments:/Conditions: (1) Install liner on contour (2) Keep septic system 50ft from stream (3) Keep well 100ft from septic system (4) Call H. Dept. to flag out septic lines before installation (if needed)

Comments:/Conditions: (1) SEPTIC TANK WITH MARKER INSTALLED USING "TUFTITE" FILTER (2) "ACCEPTED" SYSTEM INSTALLED INSTEAD OF CONVENTIONAL

INITIAL SITE SKETCH (Not to scale)

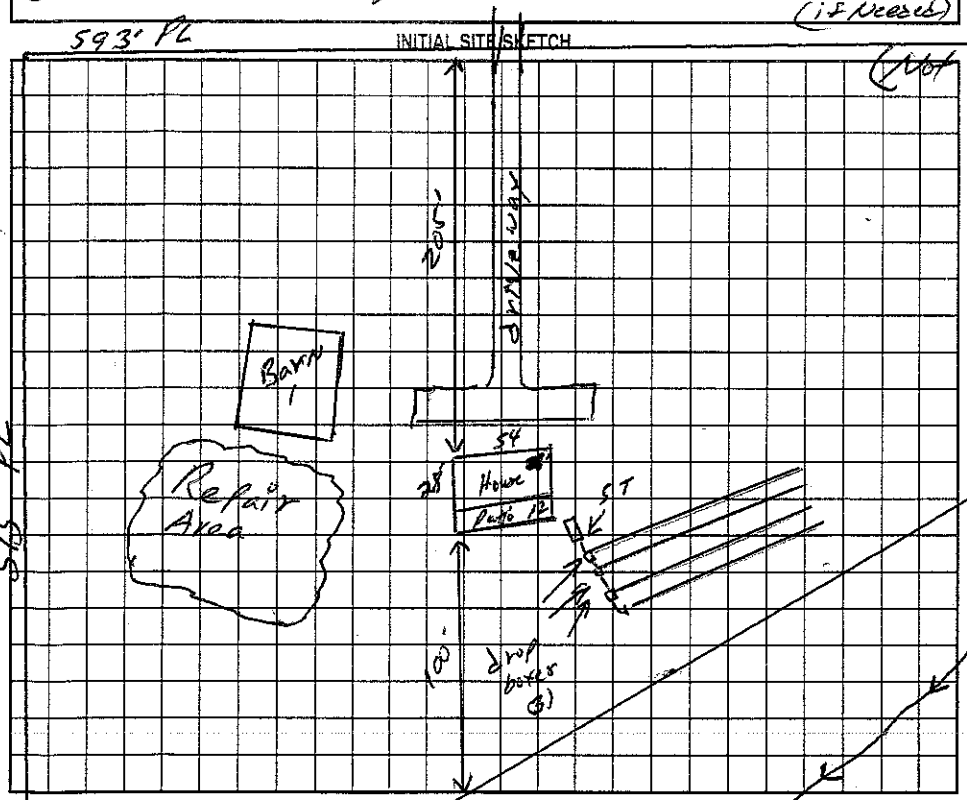

AS BUILT SKETCH

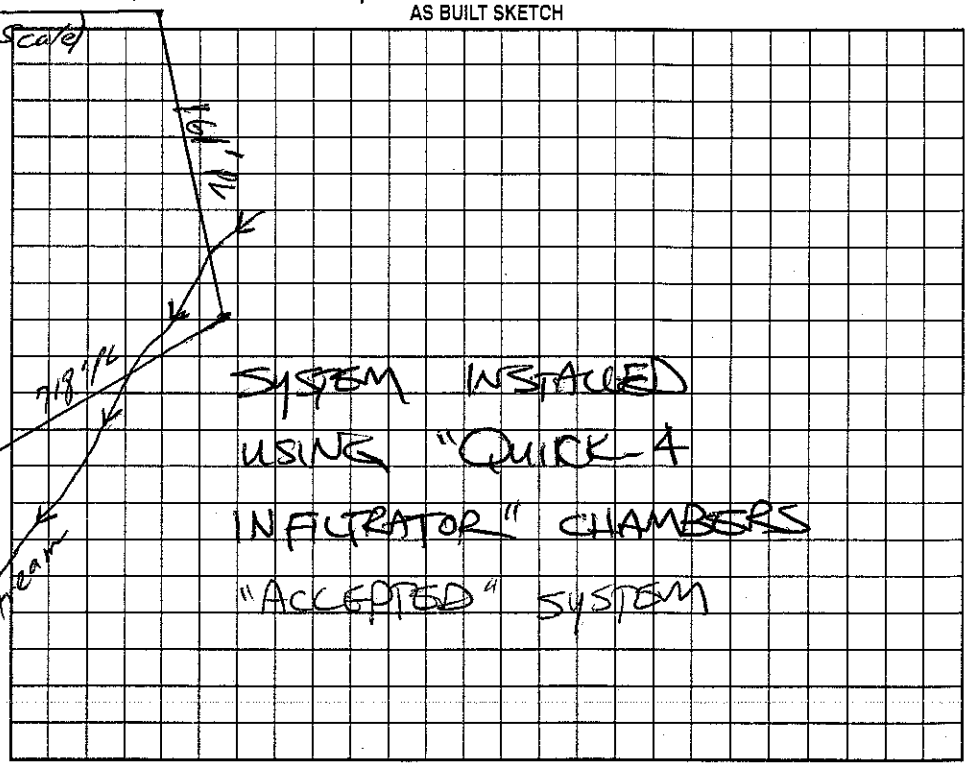

Permit can be suspended or revoked if any false information is supplied toward securing the permit/any unauthorized changes are made to the site/any unauthorized changes are made in the installation of the system. Improvement Permit with plat valid without expiration. Improvement Permit with site plan valid for sixty months. Authorization to Construct is valid for a period equal to that of Improvement Permit – not to exceed sixty months.

Signed: [signature] date 8-31-04 Installed by: TOMMY FRYE

Improvement Permit by: William O. Johnson date 8/31/04 Operation Permit by: STEVE HERRICK date 4-29-05

Authorization to Construct by: William O. Johnson date 8/31/04 Existing System Inspection by: — date —

HEALTH DEPT. COPY: WHITE OWNER COPY (FINAL): YELLOW OWNER COPY (INITIAL): PINK