IREDELL COUNTY HEALTH DEPARTMENT

STATESVILLE 704-878-5305 MOORESVILLE 704-664-5281

IMPROVEMENT PERMIT / AUTHORIZATION TO CONSTRUCT / OPERATION PERMIT / EXISTING SYSTEM INSPECTION

(5)

PERMIT# ~~01-P-01-07~~ 19170 PIN# 4731-22-3864 DATE 3-20-07

OWNER OR APPLICANT MEDALLION PROPERTIES, INC PHONE: Business 704-634-1185 Home

ADDRESS 185 Whippoorwill RD, MOORESVILLE, NC 28117

LOCATION 21 SOUTH (R) TALLEY [redacted] (L) TALLEY RIDGE, 1ST LOT ON RT

SUBDIVISION TALLEY RIDGE BLOCK / SECTION LOT 5 LOT AREA 21920 sq.ft SITE CLASS. PS DESIGN FLOW 360 L.T.A.R. .25

Septic Tank: 1000 Gallons; STB 825 Date 6-11-07

Pump Tank: Gallons; PT Date

Pump Make: Model Serial No.

Nitrification Field: No Fields 1 Square Feet EOR=1440 Linear Feet 240'

No Lines 8X30' Trench Width 24" Max Trench Bottom Depth 36"

☒ New System ☐ Repair ☐ Expansion System Type: I II (III) IV V VI

System Description: 6 GRAVITY 50% REDUCT

Repair System Description: LOW PRESSURE 50% REDUCT

Maintenance Agreement Required: ☐ Yes ☒ No

☒ House/Mod. Home No. Bedrooms 3

☐ Mobile Home No. Persons 6

☐ Business No. Employees

☐ Other

Water Supply: ☒ Individual ☐ Public ☐ Community


Gravel Depth N/A ☒ Gravity ☐ Pressure ☐ Slab ☒ Crawl Space ☐ Basement w/plumbing ☐ Basement wo/plumbing

Comments/Conditions: (1) INSTALL 1 FLOW DIVIDER TEE & 2 Distribution BOXES WITH SPEED LEVELERS (2) Install Lines On Contours & MAINTAIN SETBACKS (3) SYSTEM & REPAIR Completely FLAGGED OUT (4) FILL & PACK Ditch. Keep Lines OFF Filled


Comments/Conditions: Ditch 5'. (5) AT DATE OF SYSTEM DESIGN Neighboring Lot Setbacks Checked & Are OK.

1"=50'

INITIAL SITE SKETCH

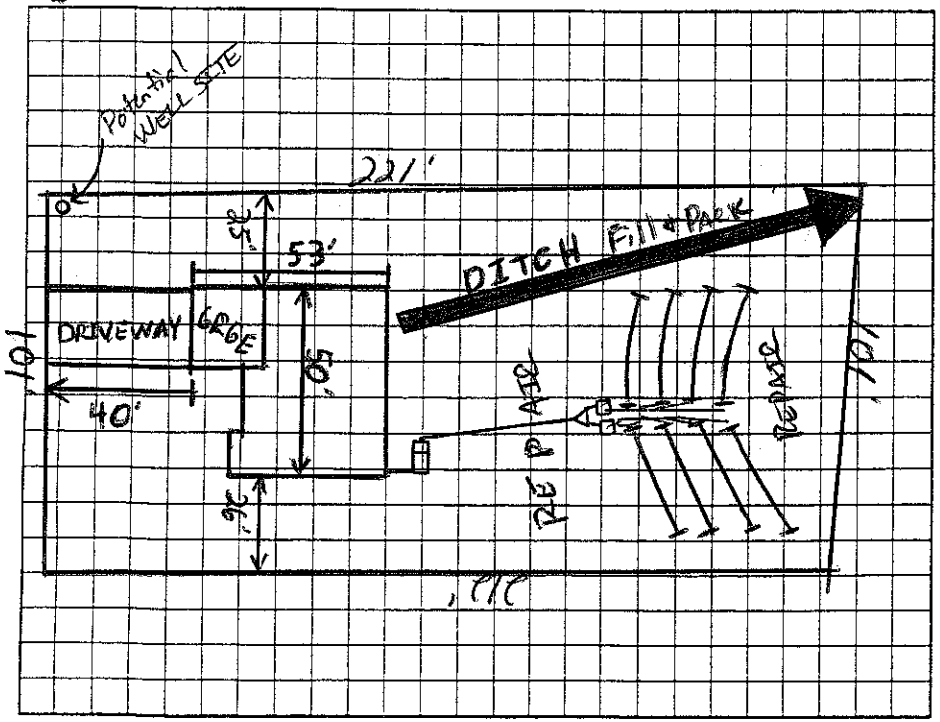

AS BUILT SKETCH

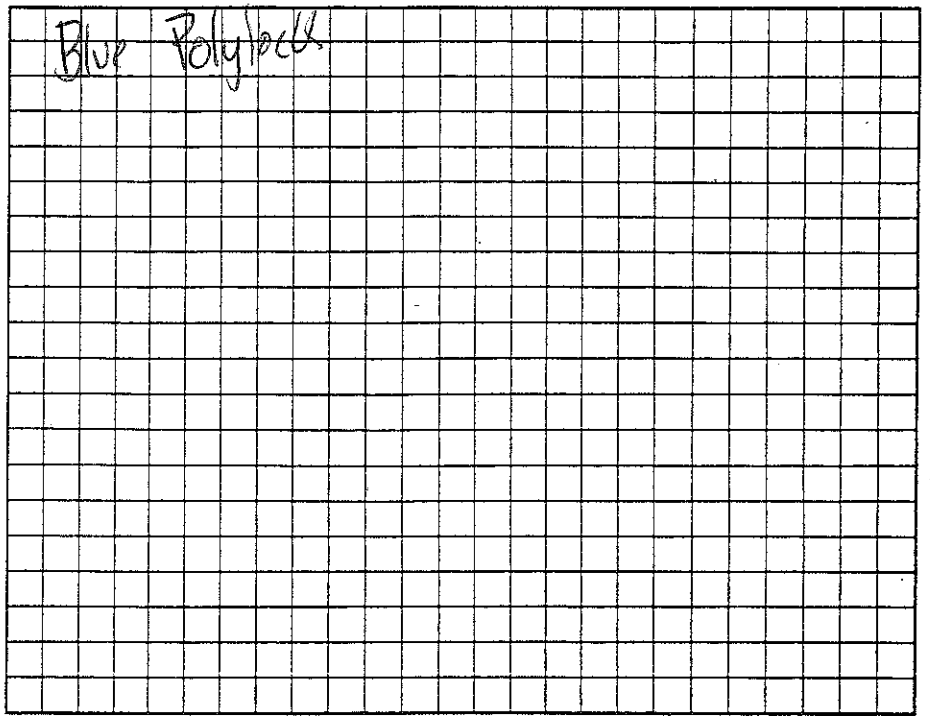

Permit can be suspended or revoked if any false information is supplied toward securing the permit/any unauthorized changes are made to the site/any unauthorized changes are made in the installation of the system. Improvement Permit with plat valid without expiration ☐ Improvement Permit with site plan valid for sixty months ☒ Authorization to Construct is valid for a period equal to that of Improvement Permit - not to exceed sixty months.

Signed: [signature] date 3/21/07 Installed by: KOWAN SEPTIC

Improvement Permit by: [signature] date 3-20-07 Operation Permit by: [signature] date 7-26-07

Authorization to Construct by: [signature] date 3-20-07 Existing System Inspection by: date

HEALTH DEPT. COPY: WHITE OWNER COPY (FINAL): YELLOW OWNER COPY (INITIAL): PINK

Tamara Hills