Permit # 180189
Bryan Cloadfelter Construction Co.

IREDELL COUNTY HEALTH DEPARTMENT

STATESVILLE 704-878-5305 MOORESVILLE 704-664-5281

IMPROVEMENT PERMIT / AUTHORIZATION TO CONSTRUCT / OPERATION PERMIT / EXISTING SYSTEM INSPECTION

PERMIT# TRUITMAN 04-05-07 | 42521 PIN# 4731-22-3973

OWNER OR APPLICANT MEDALLION PROPERTIES INC. PHONE: Business 704-634-1185 Home DATE 4-21-07

ADDRESS 185 WHIPPOORWILL ROAD, MOORESVILLE NC 28117

LOCATION US 21 SOUTH, TR TALLEY FOREST, TL TALLEY RIDGE DRIVE, 4th LOT ON RIGHT

SUBDIVISION TALLEY RIDGE BLOCK / SECTION LOT 4 LOT AREA 21,867 FT² SITE CLASS. PS DESIGN FLOW 360 L.T.A.R. 0.30 GPD/FT²

Septic Tank: 1000 Gallons: STB 825 Date 5-10-07
Pump Tank: Gallons: PT Date
Pump Make: Model EQ-P Serial No.
Nitrification Field: No Fields 1 Square Feet 1200 Linear Feet 300
No Lines FOUR Trench Width 36" Max Trench Bottom Depth 36" Gravel Depth N/A

☑ New System ☐ Repair ☐ Expansion System Type: I II III IV V VI
System Description: 25% REDUCTION SYSTEM
Repair System Description: 50% REDUCTION, GRAV/PUMP
Maintenance Agreement Required: ☐ Yes ☑ No

☑ Gravity ☐ Pressure ☐ Slab ☐ Crawl Space ☐ Basement w/plumbing ☐ Basement wo/plumbing


☑ House/Mod. Home No. Bedrooms 3
☐ Mobile Home No. Persons
☐ Business No. Employees
☐ Other

Water Supply: ☑ Individual ☐ Public ☐ Community WELL


Comments/Conditions: ① INSTALL 25% REDUCTION SYSTEM ON CONTOUR AS FLAGGED ② KEEP SYSTEM MINIMUM 100 FEET FROM WELL

Comments/Conditions: Blue Filly

INITIAL SITE SKETCH

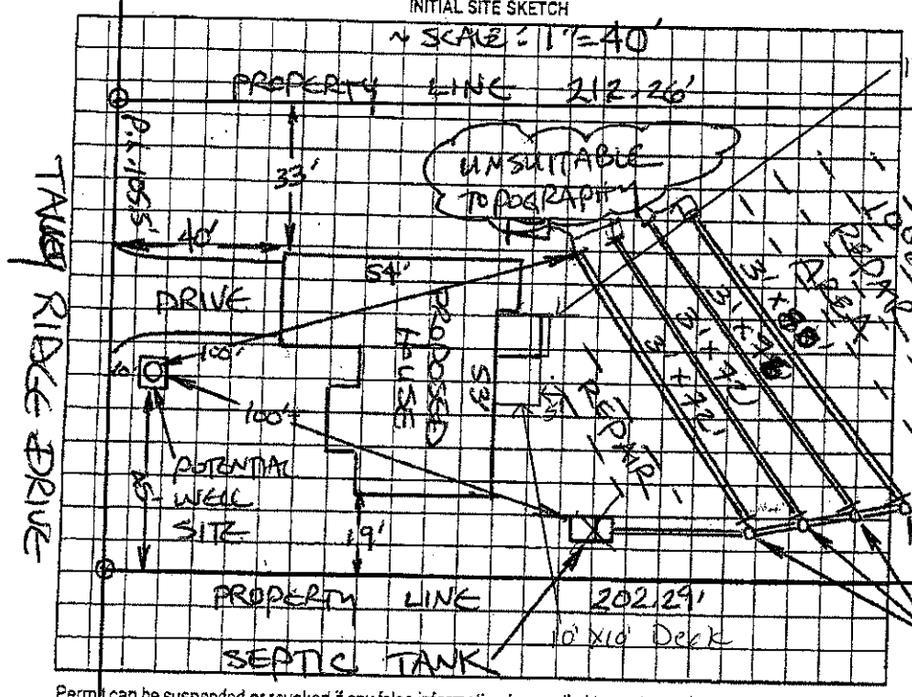

AS BUILT SKETCH

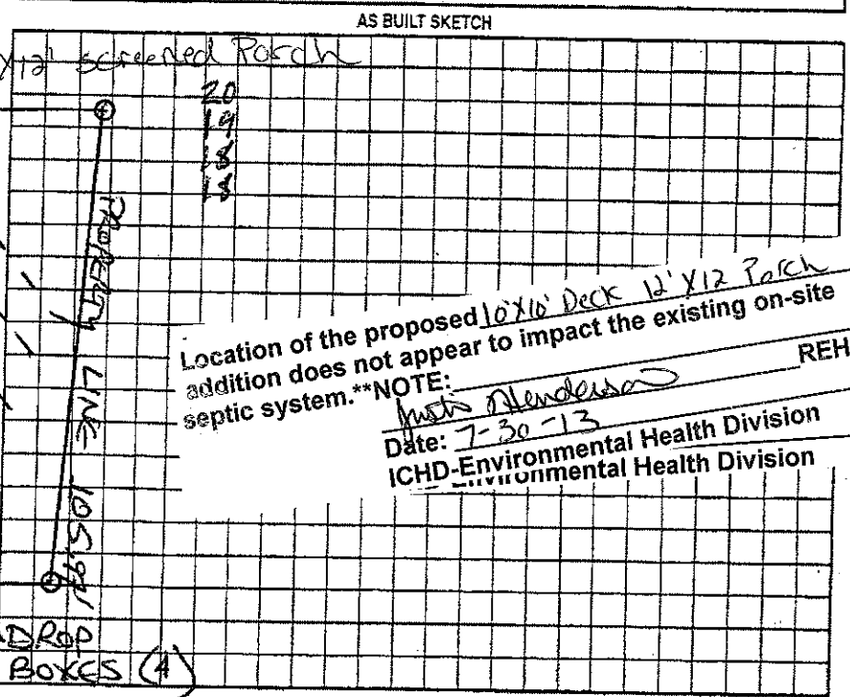

Location of the proposed 10'X10' Deck 12'X12 Porch addition does not appear to impact the existing on-site septic system.**NOTE: Justin Henderson REHS
Date: 7-30-13
ICHD-Environmental Health Division

Permit can be suspended or revoked if any false information is supplied toward securing the permit/any unauthorized changes are made to the site/any unauthorized changes are made in the installation of the system. Improvement Permit with plat valid without expiration ☐ Improvement Permit with site plan valid for sixty months ☑ Authorization to Construct is valid for a period equal to that of Improvement Permit - not to exceed sixty months.

Signed: [signature] date 4/24/07
Improvement Permit by: STEVE HEDRICK date 4-21-07
Authorization to Construct by: STEVE HEDRICK date 4-21-07
Installed by: Rowan date
Operation Permit by: [signature] date 6-20-07
Existing System Inspection by: date

HEALTH DEPT. COPY: WHITE OWNER COPY (FINAL): YELLOW OWNER COPY (INITIAL): PINK