IREDELL COUNTY HEALTH DEPARTMENT

STATESVILLE 704-878-5305 MOORESVILLE 704-664-5281

IMPROVEMENT PERMIT / AUTHORIZATION TO CONSTRUCT / OPERATION PERMIT / EXISTING SYSTEM INSPECTION

PERMIT# TRUITMAN 09-03-07 14252A PIN# 4731-22-3973 DATE 4-21-07

OWNER OR APPLICANT MEDALLION PROPERTIES, INC. PHONE: Business 704-634-1185 Home

ADDRESS 185 WHIPPOORWILL ROAD, MOORESVILLE, NC 28117

LOCATION US21 SOUTH, TR TALLEY FOREST, TL TALLEY RIDGE DRIVE, 4TH LOT ON RIGHT

SUBDIVISION TALLEY RIDGE BLOCK / SECTION LOT 4 LOT AREA 21,867 FT² SITE CLASS. PS DESIGN FLOW 360 L.T.A.R. 0.30 GPD/FT²

Septic Tank: 1000 Gallons; STB 825 Date 5-10-07

Pump Tank: Gallons; PT Date

Pump Make: Model EQ P Serial No.

Nitrification Field: No Fields 1 Square Feet 1200 Linear Feet 300

No Lines FOUR Trench Width 36" Max Trench Bottom Depth 36" Gravel Depth N/A

☑ New System ☐ Repair ☐ Expansion System Type: I II III IV V VI

System Description: 25% REDUCTION CONVEN

Repair System Description: 50% REDUCTION, GRAV/PUMP

Maintenance Agreement Required: ☐ Yes ☑ No

☑ House/Mod. Home ☐ Mobile Home ☐ Business ☐ Other

No. Bedrooms 3 No. Persons No. Employees


Water Supply: ☑ Individual ☐ Public ☐ Community WELL

☑ Gravity ☐ Pressure ☐ Slab ☐ Crawl Space ☐ Basement w/plumbing ☐ Basement wo/plumbing


Comments/Conditions: ① INSTALL 25% REDUCTION SYSTEM ON CONTOUR AS FLAGGED ② KEEP SYSTEM MINIMUM 100 FEET FROM WELL

Comments/Conditions: Blue Filter

INITIAL SITE SKETCH

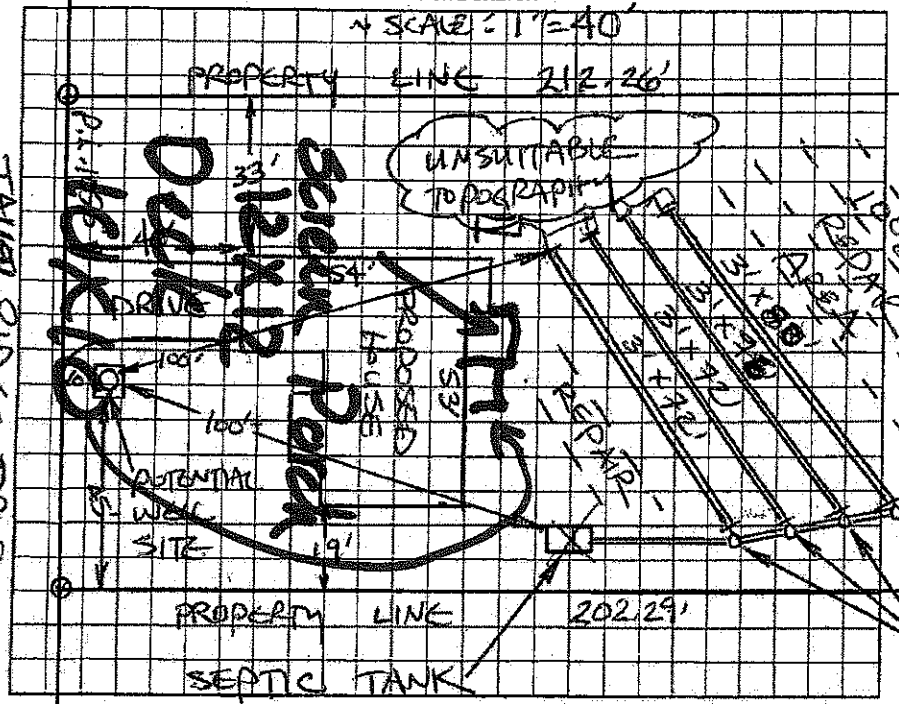

AS BUILT SKETCH

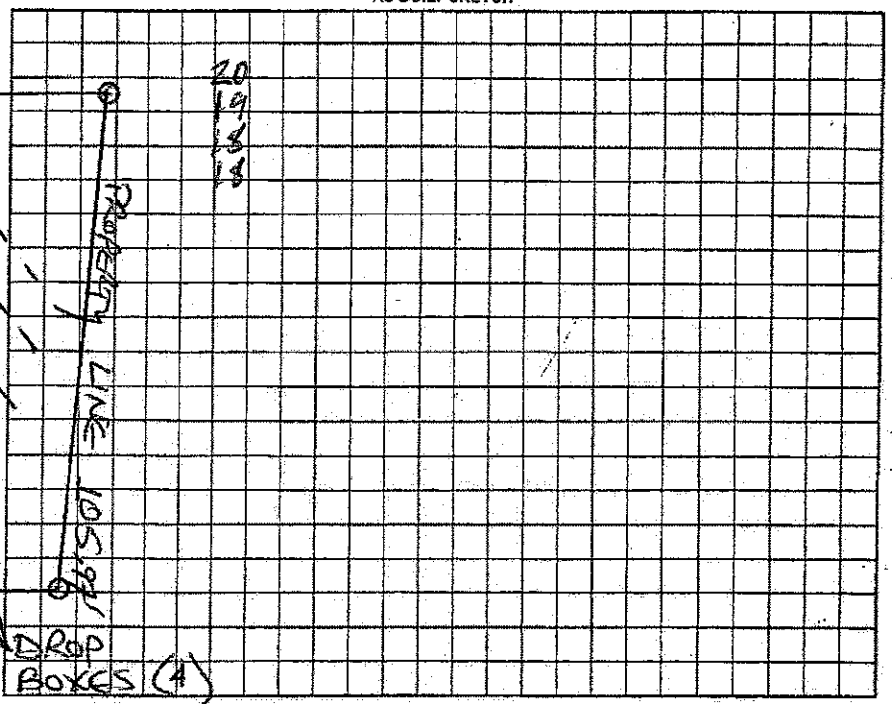

Permit can be suspended or revoked if any false information is supplied toward securing the permit/any unauthorized changes are made to the site/any unauthorized changes are made in the installation of the system. Improvement Permit with plat valid without expiration ☐ Improvement Permit with site plan valid for sixty months ☑ Authorization to Construct is valid for a period equal to that of Improvement Permit – not to exceed sixty months.

Signed: [signature] date 4/24/07

Improvement Permit by: STEVE HEDRICK date 4-21-07

Authorization to Construct by: STEVE HEDRICK date 4-21-07

Installed by: RONNIE SMITH

Operation Permit by: [signature] date 6-20-07

Existing System Inspection by: date

HEALTH DEPT. COPY: WHITE OWNER COPY (FINAL): YELLOW OWNER COPY (INITIAL): PINK