13830 1 4731226303

IREDELL COUNTY HEALTH DEPARTMENT

STATESVILLE 704-878-5305 MOORESVILLE 704-664-5281

IMPROVEMENT PERMIT / AUTHORIZATION TO CONSTRUCT / OPERATION PERMIT / EXISTING SYSTEM INSPECTION

PERMIT# TROUTMAN 13830 PIN# 4731-22-5803.11 DATE 08/30/06

OWNER OR APPLICANT MEDALLION PROPERTIES, INC. PHONE: Business 704-634-1185 Home 704-361-1084

ADDRESS 185 WHIPPERWILL RD. MOORESVILLE, NC 28117

LOCATION HWY 21 SOUTH, (R) TALLEY ST., (L) TALLEY HILLS DR., LOT ON LEFT IN CUL-DE-SAC

SUBDIVISION TALLEY RIDGE BLOCK / SECTION ____ LOT 11 LOT AREA 0.50 AC. SITE CLASS. PS DESIGN FLOW 360 GPD L.T.A.R. 0.30 GPD/FT²

Septic Tank: 1,000 Gallons; STB 825 Date 10-25-06
Pump Tank: ____ Gallons; PT ____ Date ____
Pump Make: ____ Model ____ Serial No. ____
Nitrification Field: No Fields 1 Square Feet EQ to 1200 Linear Feet 200'
No Lines 5@40' Trench Width 24" Max Trench Bottom Depth 36" Gravel Depth N/A

☒ New System ☐ Repair ☐ Expansion System Type: I II III IV V VI
System Description: 50% REDUCTION, GRAVITY
Repair System Description: 50% REDUC, LOW PRESS.
Maintenance Agreement Required: ☐ Yes ☒ No
☒ Gravity ☐ Pressure ☐ Slab ☒ Crawl Space ☐ Basement w/plumbing ☐ Basement wo/plumbing

☒ House/Mod. Home ☐ Mobile Home ☐ Business ☐ Other
No. Bedrooms 3 No. Persons ____ No. Employees ____


Water Supply: ☒ Individual WELL ☐ Public ☐ Community

Comments:/Conditions:

Comments:/Conditions: (1) INSTALLED @ 4 LINES X 50' LOW 6 SAND X-tra line of spair below with Builders Permission, System installed 10' off property P/L SYSTEM LAID 6' LOWER AT LOW SIDE AT TIME OF CHECK

*SCALE 1" = 1"=50' INITIAL SITE SKETCH

EXPLAINED TO BUILDER TO BE CAREFUL WITH LANDSCAPING TO NOT REMOVE SOIL.

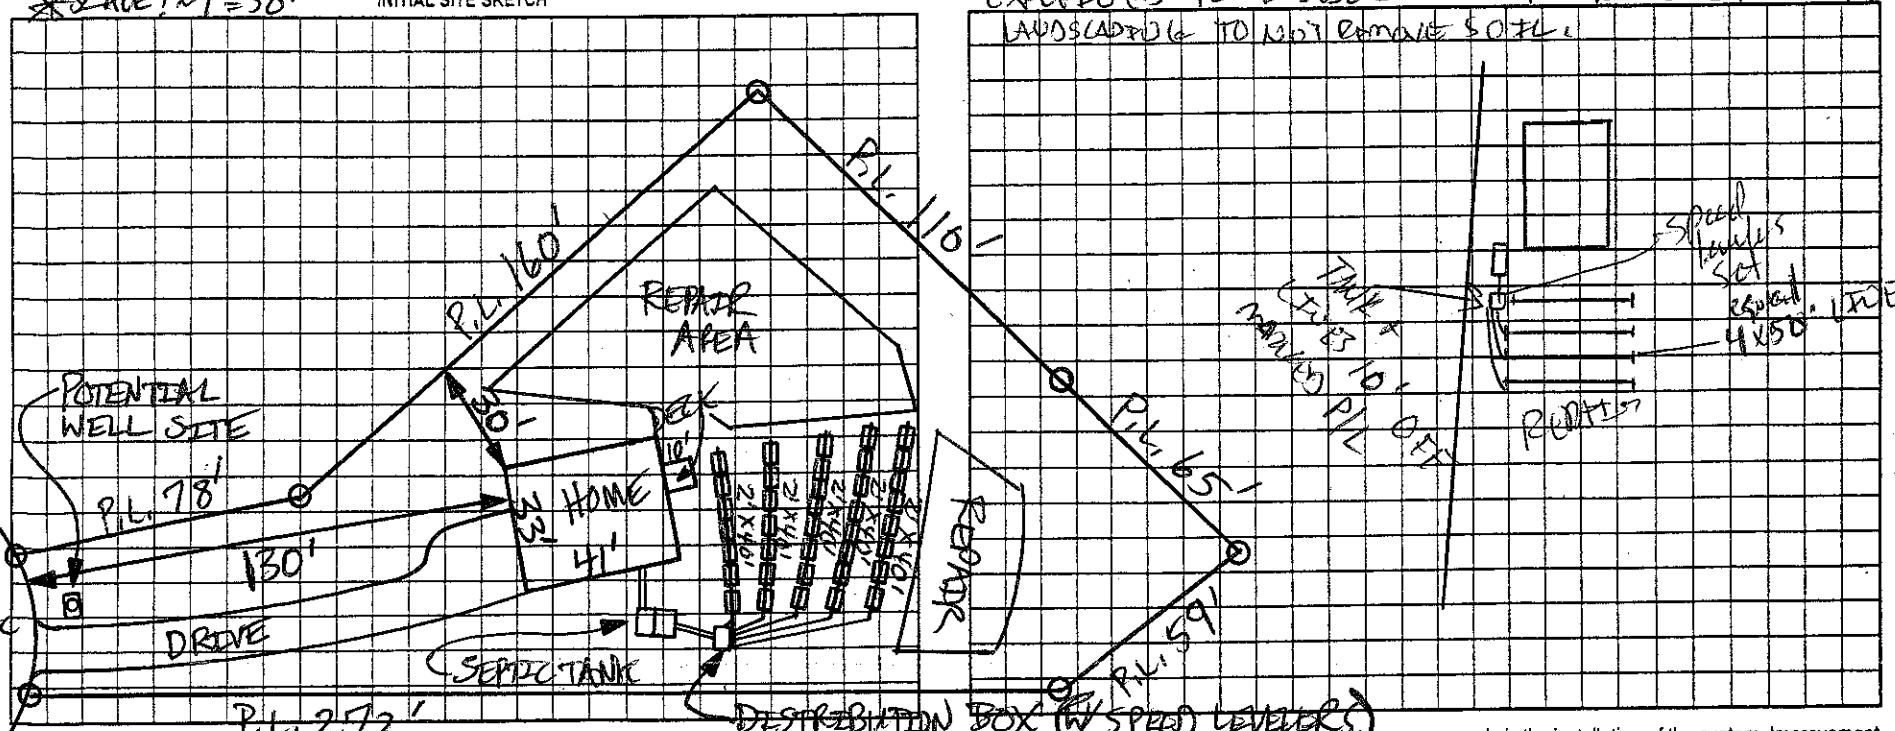

Permit can be suspended or revoked if any false information is supplied toward securing the permit/any unauthorized changes are made to the site/any unauthorized changes are made in the installation of the system. Improvement Permit with plat valid without expiration. ☐ Improvement Permit with site plan valid for sixty months. ☒ Authorization to Construct is valid for a period equal to that of Improvement Permit – not to exceed sixty months.

Signed: [signature] date 8/30/06
Improvement Permit by: [signature] date 08/30/06
Authorization to Construct by: [signature] date 08/30/06

Installed by: POWAN SEPTIC
Operation Permit by: [signature] date 1-12-07
Existing System Inspection by: ____ date ____

HEALTH DEPT. COPY: WHITE OWNER COPY (FINAL): YELLOW OWNER COPY (INITIAL): PINK

13830 1 4731226303

IREDELL COUNTY HEALTH DEPARTMENT

STATESVILLE 704-878-5305 MOORESVILLE 704-664-5281

IMPROVEMENT PERMIT / AUTHORIZATION TO CONSTRUCT / OPERATION PERMIT / EXISTING SYSTEM INSPECTION

PERMIT# TROUTMAN 13830 PIN# 4731-22-5803.11 DATE 08/30/06

OWNER OR APPLICANT MEDALLION PROPERTIES, INC. PHONE: Business 704-634-1185 Home 704-361-1084

ADDRESS 185 WHIPPERWILL RD. MOORESVILLE, NC 28117

LOCATION HWY 21 SOUTH, (R) TALLEY ST., (L) TALLEY HILLS DR., LOT ON LEFT IN CUL-DE-SAC

SUBDIVISION TALLEY RIDGE BLOCK / SECTION ____ LOT 11 LOT AREA 0.50 AC. SITE CLASS. PS DESIGN FLOW 360 GPD L.T.A.R. 0.30 GPD/FT²

Septic Tank: 1,000 Gallons; STB 825 Date 10-25-06
Pump Tank: ____ Gallons; PT ____ Date ____
Pump Make: ____ Model ____ Serial No. ____
Nitrification Field: No Fields 1 Square Feet 150 to 200 Linear Feet 200'
No Lines 5 @ 40' Trench Width 24" Max Trench Bottom Depth 36"

☒ New System ☐ Repair ☐ Expansion System Type: I II III IV V VI
System Description: 50% REDUCTION, GRAVITY
Repair System Description: 50% REDUC., LOW PRESS.
Maintenance Agreement Required: ☐ Yes ☒ No
Gravel Depth N/A ☒ Gravity ☐ Pressure ☐ Slab ☒ Crawl Space ☐ Basement w/plumbing ☐ Basement wo/plumbing

☒ House/Mod. Home No. Bedrooms 3
☐ Mobile Home No. Persons ____
☐ Business No. Employees ____
☐ Other ____

Water Supply: ☒ Individual WELL ☐ Public ☐ Community


Comments:/Conditions:

Comments:/Conditions: (1) INSTALLED @ 4 LINES x 50' LOW & SAVED extra line of repair below with Builder's Permission. System installed 10' off proposed P/L. System had 6' cover at low side at time of check


EXPLAINED TO BUILDER TO BE CAREFUL WITH LANDSCAPING TO NOT REMOVE SOIL.

*SCALE: 1" = 50'

INITIAL SITE SKETCH

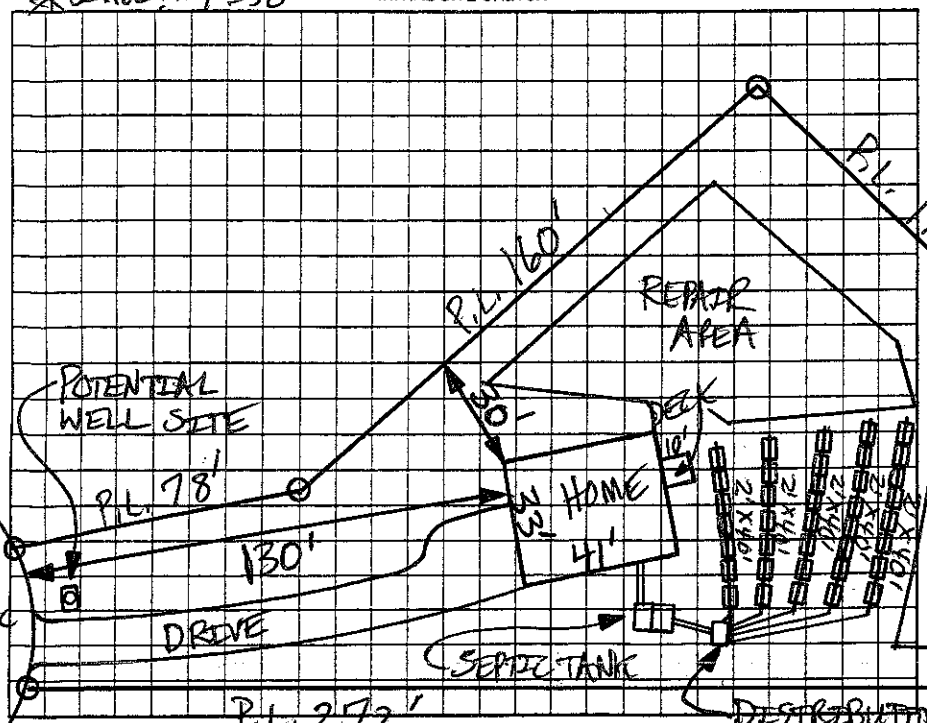

AS BUILT SKETCH

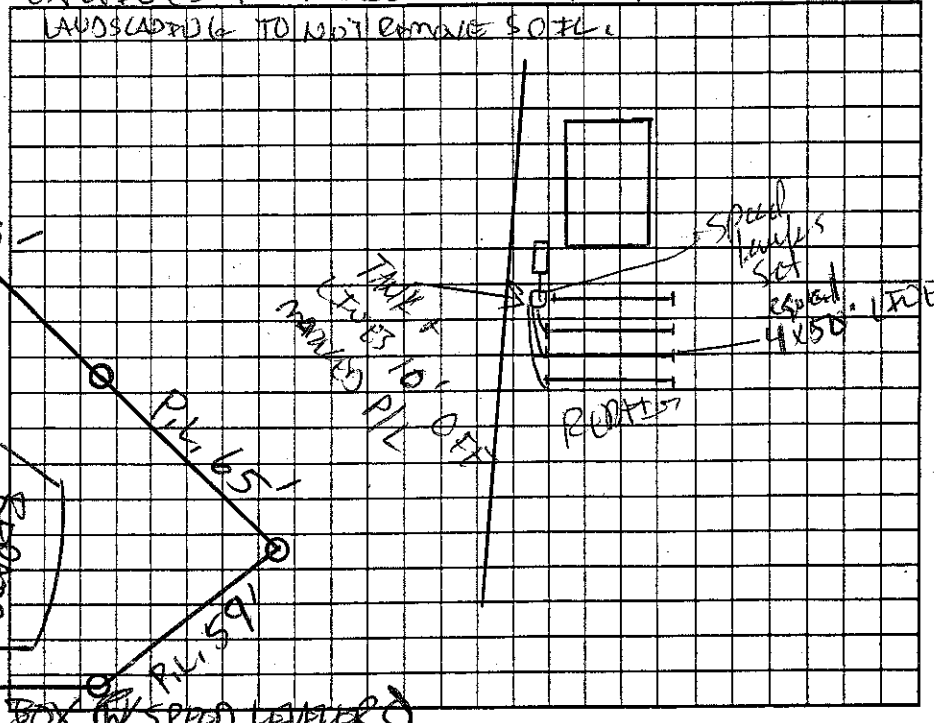

Permit can be suspended or revoked if any false information is supplied toward securing the permit/any unauthorized changes are made to the site/any unauthorized changes are made in the installation of the system. Improvement Permit with plat valid without expiration. ☐ Improvement Permit with site plan valid for sixty months. ☒ Authorization to Construct is valid for a period equal to that of Improvement Permit – not to exceed sixty months.

Signed: [signature] date 8/30/06 Installed by: POWAN SEPTIC

Improvement Permit by: [signature] date 08/30/06 Operation Permit by: [signature] date 1-12-07

Authorization to Construct by: [signature] date 08/30/06 Existing System Inspection by: ____ date ____

HEALTH DEPT. COPY: WHITE OWNER COPY (FINAL): YELLOW OWNER COPY (INITIAL): PINK