137848

IREDELL COUNTY HEALTH DEPARTMENT

STATESVILLE 704-878-5305 MOORESVILLE 704-664-5281

IMPROVEMENT PERMIT / AUTHORIZATION TO CONSTRUCT / OPERATION PERMIT / EXISTING SYSTEM INSPECTION

PERMIT# TROUTMAN B"7848 PIN# 4731-22-~~5803.12~~ 6434 DATE 08/23/06

OWNER OR APPLICANT MEDALLION PROPERTIES, INC. PHONE: Business 704-634-1185 Home 704-361-1084

ADDRESS 185 WHIPPOORWILL RD, MOORESVILLE NC 28117

LOCATION HWY 21 SOUTH, (R) TALLEY RD., (L) TALLEY HILLS DR, LOT ON LEFT,

SUBDIVISION TALLEY RIDGE BLOCK / SECTION ____ LOT 12 LOT AREA 0.50 ACRES SITE CLASS. PS DESIGN FLOW 360 GPD L.T.A.R. 0.275 GPD/FT²

Septic Tank: 1,000 Gallons; STB 825 Date 10-18-06
Pump Tank: 1,000 Gallons; PT 307 Date 9-3-06
Pump Make: Zoeller Model N-152 Serial No. ____
Nitrification Field: No Fields 1 Square Feet EQ to 1310 Linear Feet 220'
No Lines 5@45' Trench Width 24" Max Trench Bottom Depth (32")

☒ New System ☐ Repair ☐ Expansion System Type: I II (III) IV V VI
System Description: 50% REDUC., PUMP
Repair System Description: 50% REDUC., LOW PRESS.
Maintenance Agreement Required: ☐ Yes ☒ No
Gravel Depth N/A ☐ Gravity ☒ Pressure ☐ Slab ☒ Crawl Space ☐ Basement w/plumbing ☐ Basement wo/plumbing


☒ House/Mod. Home No. Bedrooms 3
☐ Mobile Home No. Persons ____
☐ Business No. Employees ____
☐ Other ____

Water Supply: ☒ Individual WELL ☐ Public ☐ Community


Comments:/Conditions: (1) SEE ATTACHED PUMP & PRESSURE MANIFOLD INFO DIAGRAMS,

Comments:/Conditions: Blue Filter

INITIAL SITE SKETCH *SCALE; N1"=40'

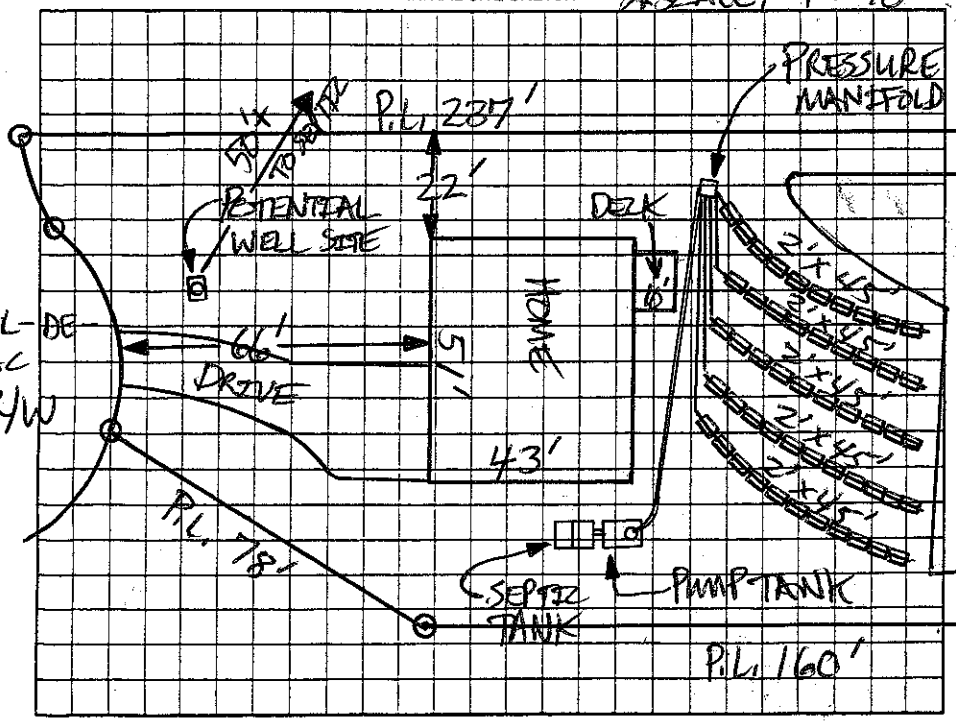

AS BUILT SKETCH

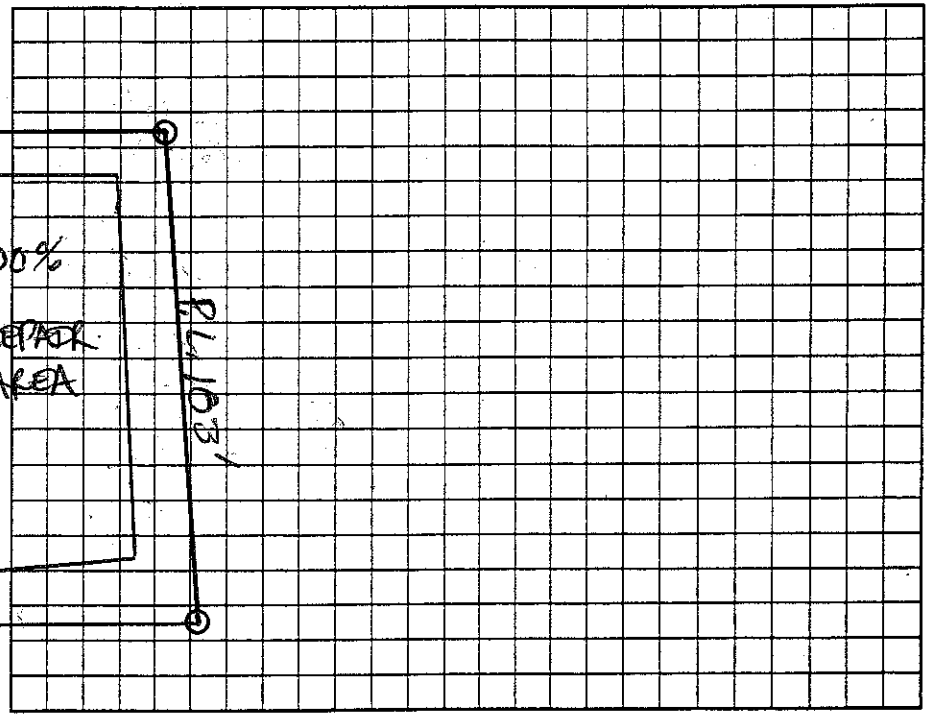

Permit can be suspended or revoked if any false information is supplied toward securing the permit/any unauthorized changes are made to the site/any unauthorized changes are made in the installation of the system. Improvement Permit with plat valid without expiration. ☐ Improvement Permit with site plan valid for sixty months ☒ Authorization to Construct is valid for a period equal to that of Improvement Permit – not to exceed sixty months.

Signed: [signature] date 8/24/06
Improvement Permit by: [signature] date 08/23/06
Authorization to Construct by: [signature] date 08/24/06

Installed by: ROWAN SEPTIC
Operation Permit by: [signature] date 1-17-07
Existing System Inspection by: ____ date ____

HEALTH DEPT. COPY: WHITE OWNER COPY (FINAL): YELLOW OWNER COPY (INITIAL): PINK

