137847

IREDELL COUNTY HEALTH DEPARTMENT

STATESVILLE 704-878-5305 MOORESVILLE 704-664-5281

IMPROVEMENT PERMIT / AUTHORIZATION TO CONSTRUCT / OPERATION PERMIT / EXISTING SYSTEM INSPECTION

PERMIT# TROUTMAN PIN# 4731-22-~~5803.13~~ 6505 DATE 08/23/06

OWNER OR APPLICANT MEDALLION PROPERTIES, INC. PHONE: Business 704-634-1185 Home 704-361-1084

ADDRESS 185 WHIPPOORWILL RD, MOORESVILLE, NC 28117

LOCATION HWY 21, SOUTH (R) TALLEY RD, (L) TALLEY HILLS DR., LOT ON LEFT.

SUBDIVISION TALLEY RIDGE BLOCK / SECTION ____ LOT 13 LOT AREA 0.53 ACRES SITE CLASS. PS DESIGN FLOW 360 GPD L.T.A.R. 0.275 ~~GPD/FT²~~

Septic Tank: 1,000 Gallons; STB ~~ROOT~~ 825 Date 4-6-6

Pump Tank: 1,000 Gallons; PT ~~ZOE~~ 302 Date 8-9-6

Pump Make: Zoeller Model N152 Serial No. ____

Nitrification Field: No Fields 1 Square Feet EQ to 1310 Linear Feet 225'

No Lines 5 @ 45' Trench Width 24" Max Trench Bottom Depth 36" Gravel Depth N/A ☐ Gravity ☒ Pressure ☐ Slab ☒ Crawl Space ☐ Basement w/plumbing ☐ Basement wo/plumbing

☒ New System ☐ Repair ☐ Expansion System Type: I II (III) IV V VI

System Description: 50% REDUC., PUMP

Repair System Description: 50% REDUC., LOW PRESS.

Maintenance Agreement Required: ☐ Yes ☒ No

☒ House/Mod. Home No. Bedrooms 3

☐ Mobile Home No. Persons ____

☐ Business No. Employees ____


☐ Other ____

Water Supply: ☒ Individual WELL ☐ Public ☐ Community


Comments:/Conditions: (1) SEE ATTACHED PUMP & PRESSURE MANIFOLD INFO DIAGRAMS.

Comments:/Conditions:

INITIAL SITE SKETCH * SCALE: 1" = 40'

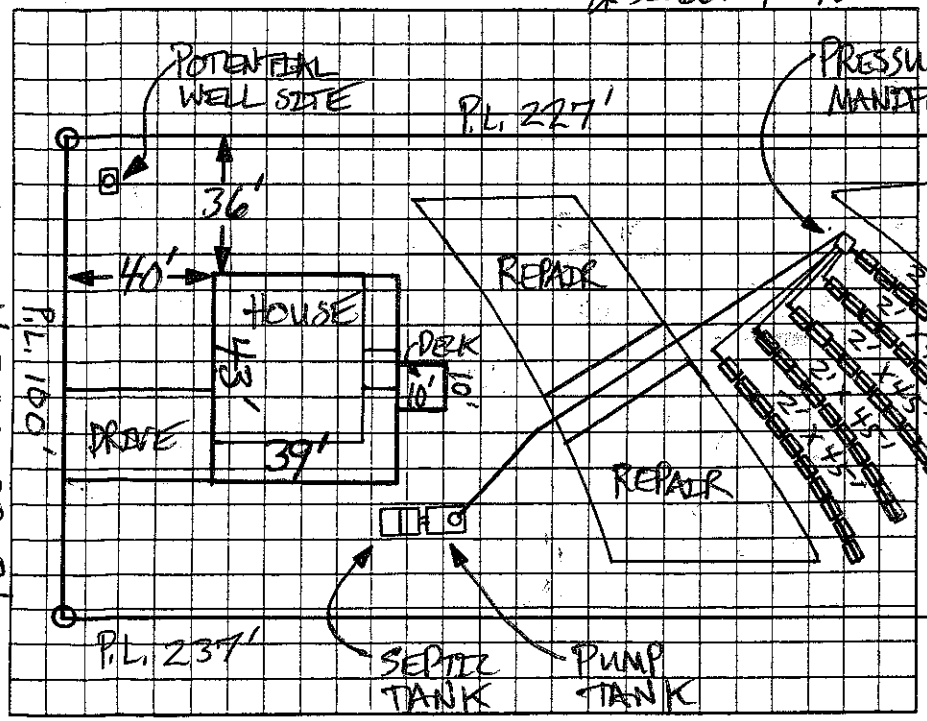

AS BUILT SKETCH

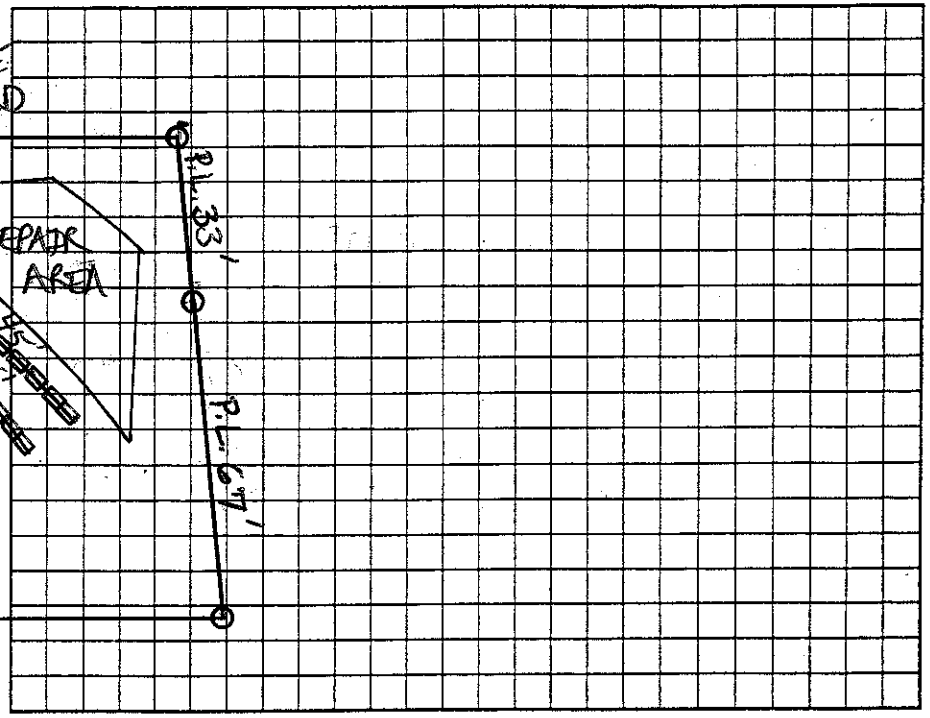

Permit can be suspended or revoked if any false information is supplied toward securing the permit/any unauthorized changes are made to the site/any unauthorized changes are made in the installation of the system. Improvement Permit with plat valid without expiration ☐ Improvement Permit with site plan valid for sixty months ☒ Authorization to Construct is valid for a period equal to that of Improvement Permit – not to exceed sixty months.

Signed: [signature] date 8/24/06 Installed by: KOWAN SEPTIC

Improvement Permit by: [signature] date 08/23/06 Operation Permit by: [signature] date 1-3-07

Authorization to Construct by: [signature] date 08/24/06 Existing System Inspection by: ____ date ____

HEALTH DEPT. COPY: WHITE OWNER COPY (FINAL): YELLOW OWNER COPY (INITIAL): PINK