138299

IREDELL COUNTY HEALTH DEPARTMENT

STATESVILLE 704-878-5305 MOORESVILLE 704-664-5281

IMPROVEMENT PERMIT / AUTHORIZATION TO CONSTRUCT / OPERATION PERMIT / EXISTING SYSTEM INSPECTION

PERMIT# TROUTMAN PIN# 4731-22-5803.14 6613 DATE 09/19/06

OWNER OR APPLICANT MEDALLION PROPERTIES, INC. PHONE: Business 704-634-1185 Home 704-361-1084

ADDRESS 185 WHIPPOORWILL RD, MOORESVILLE, NC 28117

LOCATION HWY 21 SOUTH (R) TALLEY ST., (L) TALLEY HILLS DR., LOT ON LEFT,

SUBDIVISION TALLEY RIDGE BLOCK / SECTION ____ LOT 14 LOT AREA 0.5 ACRES SITE CLASS. PS DESIGN FLOW 360 GPD L.T.A.R. 0.30 GPD/FT²

Septic Tank: 1,000 Gallons; STB 825 Date 10-27-06
Pump Tank: 1,000 Gallons; PT 307 Date 10-03-06
Pump Make: Zoeller Model N 132 Serial No. ____
Nitrification Field: No Fields 1 Square Feet EQ to 1,200 Linear Feet 300'
No Lines 4 @ 75' Trench Width 36" *Max Trench Bottom Depth 26"

☒ New System ☐ Repair ☐ Expansion System Type: I II (III) IV V VI
System Description: PUMP, 25% REDUCTION
Repair System Description: 50% REDUC., PUMP
Maintenance Agreement Required: ☐ Yes ☒ No
Gravel Depth N/A ☐ Gravity ☒ Pressure ☐ Slab ☒ Crawl Space ☐ Basement w/plumbing ☐ Basement wo/plumbing


☒ House/Mod. Home No. Bedrooms 3
☐ Mobile Home No. Persons ____
☐ Business No. Employees ____
☐ Other ____

Water Supply: ☒ Individual WELL ☐ Public ☐ Community


Comments/Conditions: (1) SEE ATTACHED PUMP AND PRESSURE MANIFOLD DIAGRAMS & INFO, (2) MAX TRENCH DEPTH IS 26".

Comments/Conditions:

INITIAL SITE SKETCH *SCALE: ~1" = 40'

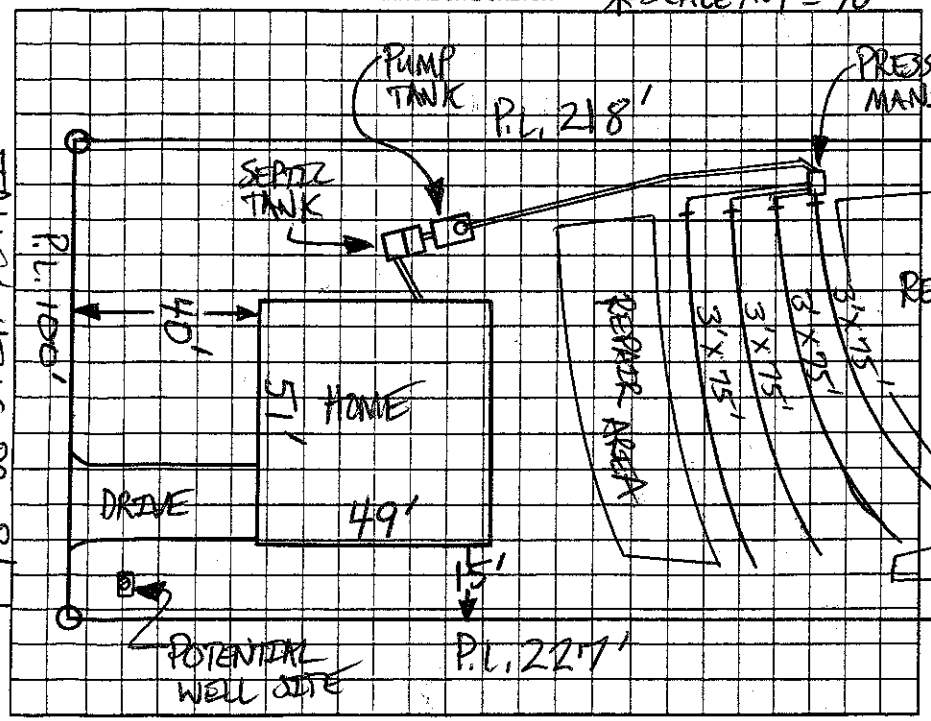

AS BUILT SKETCH

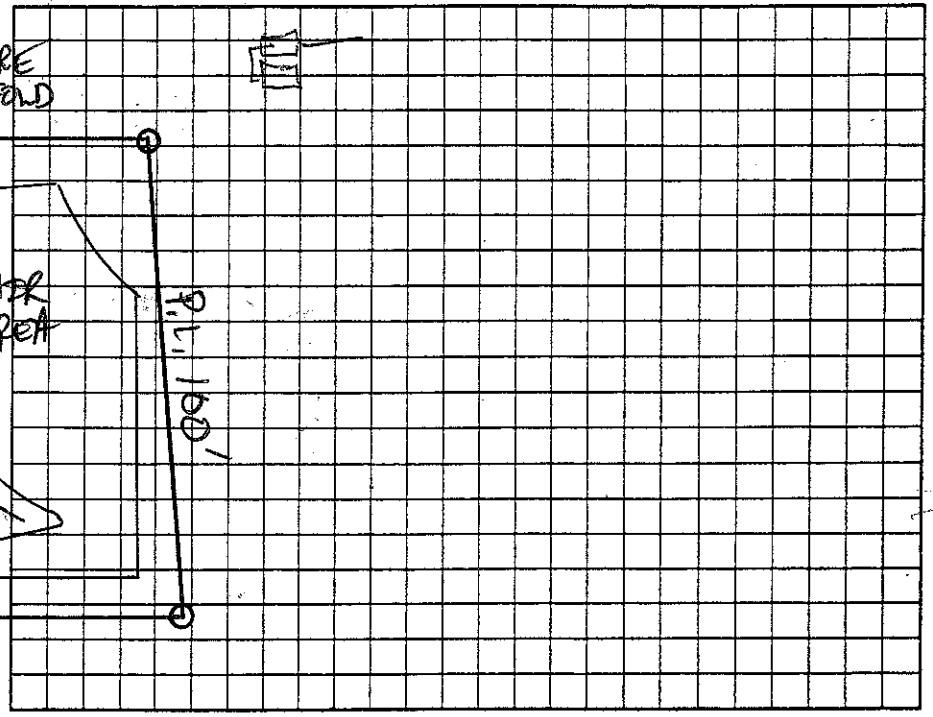

Permit can be suspended or revoked if any false information is supplied toward securing the permit/any unauthorized changes are made to the site/any unauthorized changes are made in the installation of the system. Improvement Permit with plat valid without expiration ☐ Improvement Permit with site plan valid for sixty months ☒ Authorization to Construct is valid for a period equal to that of Improvement Permit – not to exceed sixty months.

Signed: Neil Campagna date 9/20/06 Installed by: ROWAN SEPTIC

Improvement Permit by: Patrick Mitchell date 09/19/06 Operation Permit by: ____ date 1-31-07

Authorization to Construct by: Patrick Mitchell date 09/19/06 Existing System Inspection by: ____ date ____

HEALTH DEPT. COPY: WHITE OWNER COPY (FINAL): YELLOW OWNER COPY (INITIAL): PINK