14M90

IREDELL COUNTY HEALTH DEPARTMENT

STATESVILLE 704-878-5305 MOORESVILLE 704-664-5281

IMPROVEMENT PERMIT / AUTHORIZATION TO CONSTRUCT / OPERATION PERMIT / EXISTING SYSTEM INSPECTION

PERMIT# ~~02-1-01-07-14M90~~ PIN# 4731-22-6976 DATE 3-20-07

OWNER OR APPLICANT Medallion Properties PHONE: Business 704-634-1185 Home

ADDRESS 185 Whippoorwill RD Mooresville NC 28117

LOCATION 21 South (R) TALLEY RD (L) TALLEY HILLS on LEFT

SUBDIVISION TALLEY RIDGE BLOCK / SECTION LOT 17 LOT AREA 21863 SITE CLASS. PS DESIGN FLOW 360 L.T.A.R. .5

Septic Tank: 1000 Gallons; STB 825 Date 5-16-07
Pump Tank: 1000 Gallons; PT 302 Date 5-01-07
Pump Make: Zoeller Model N152B Serial No.
Nitrification Field: No Fields 1 Square Feet 50=1200' Linear Feet 200'
No Lines 4x50' Trench Width 24" Max Trench Bottom Depth 36' Gravel Depth N/A ☐ Gravity ☒ Pressure ☐ Slab ☒ Crawl Space ☐ Basement w/plumbing ☐ Basement wo/plumbing

☒ New System ☐ Repair ☐ Expansion System Type: I II (III) IV V VI
System Description: PUMP 50%
Repair System Description: LP 50%
Maintenance Agreement Required: ☐ Yes ☒ No


☒ House/Mod. Home ☐ Mobile Home ☐ Business ☐ Other
No. Bedrooms 3 No. Persons 6 No. Employees

Water Supply: ☒ Individual ☐ Public ☐ Community

Comments/Conditions: (1) Initial System is in clay soils, 50% setback is allowed (2) ~~[illegible] repair~~ (2) Repair can be 50' to well. (3) Keep house out of

Comments/Conditions: Ground & Backfill for positive drainage reports, (4) Maintain setbacks (5) Call Prior to installation for pump reports if necessary

INITIAL SITE SKETCH

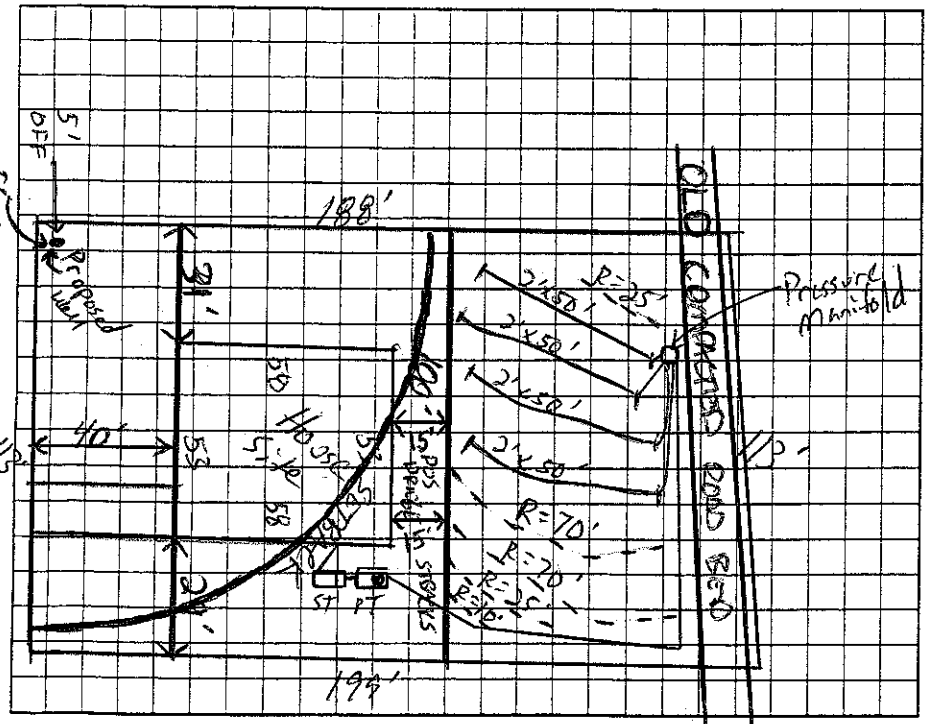

AS BUILT SKETCH

Talley Hills Dr

Permit can be suspended or revoked if any false information is supplied toward securing the permit/any unauthorized changes are made to the site/any unauthorized changes are made in the installation of the system. Improvement Permit with plat valid without expiration ☐ Improvement Permit with site plan valid for sixty months ☒ Authorization to Construct is valid for a period equal to that of Improvement Permit – not to exceed sixty months.

Signed: [signature] date 3/22/07 Installed by: Rayon Septic

Improvement Permit by: [signature] date 3-21-07 Operation Permit by: [signature] date 7-17-07

Authorization to Construct by: [signature] date 3-21-07 Existing System Inspection by: date

HEALTH DEPT. COPY: WHITE OWNER COPY (FINAL): YELLOW OWNER COPY (INITIAL): PINK