IREDELL COUNTY HEALTH DEPARTMENT

STATESVILLE 704-878-5305 CI MOORESVILLE 704-664-5281

IMPROVEMENT PERMIT / AUTHORIZATION TO CONSTRUCT / OPERATION PERMIT / EXISTING SYSTEM INSPECTION

PERMIT# TROY MAY 03-03-07 / 142522 PIN# 4731-23-3094 DATE 9-21-07

OWNER OR APPLICANT MEDALLION PROPERTIES, INC PHONE: Business 704-634-1185 Home

ADDRESS 185 WHIPPOORWILL ROAD, MOORESVILLE NC 28117

LOCATION US 21 SOUTH, TR TALLEY ~~BARRET~~, TL TALLEY RIDGE DRIVE, 3RD LOT ON RIGHT

SUBDIVISION TALLEY RIDGE BLOCK / SECTION LOT 3' LOT AREA 21,871 FT² SITE CLASS. PS' DESIGN FLOW 360 L.T.A.R. 0.30 GPD/FT²

Septic Tank: 1000 Gallons: STB 825 Date 7-25-07

Pump Tank: Gallons; PT Date

Pump Make: Model EQ. TO 1,200 Serial No.

Nitrification Field: No Fields 1 Square Feet Linear Feet 300

No Lines FOUR Trench Width 36" Max Trench Bottom Depth 36"

☑ New System ☐ Repair ☐ Expansion System Type: I II III IV V VI

System Description: 25% REDUCTION SYSTEM

Repair System Description: 50% REDUCTION, GRAV PUMP

Maintenance Agreement Required: ☐ Yes ☐ No

Gravel Depth N/A ☑ Gravity ☐ Pressure

☑ House/Mod. Home No. Bedrooms 3

☐ Mobile Home No. Persons

☐ Business No. Employees

☐ Other

Water Supply: ☑ Individual ☐ Public ☐ Community WELL


☐ Slab ☑ Crawl Space ☐ Basement w/plumbing ☐ Basement wo/plumbing

Comments:/Conditions: ① INSTALL 25% REDUCTION SYSTEM ON CONTOUR AS FLAGGED ② KEEP SYSTEM MINIMUM 100 FEET FROM WELL.


Comments:/Conditions:

Blue Tuf Tite Filter

INITIAL SITE SKETCH ~ SCALE: 1" = 40'

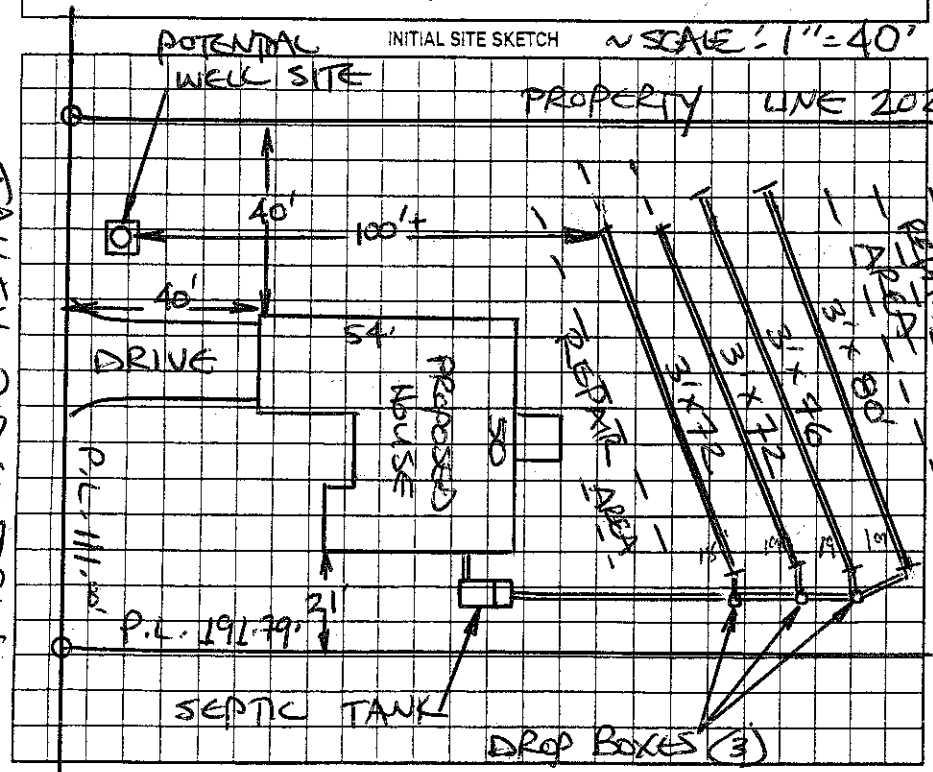

AS BUILT SKETCH

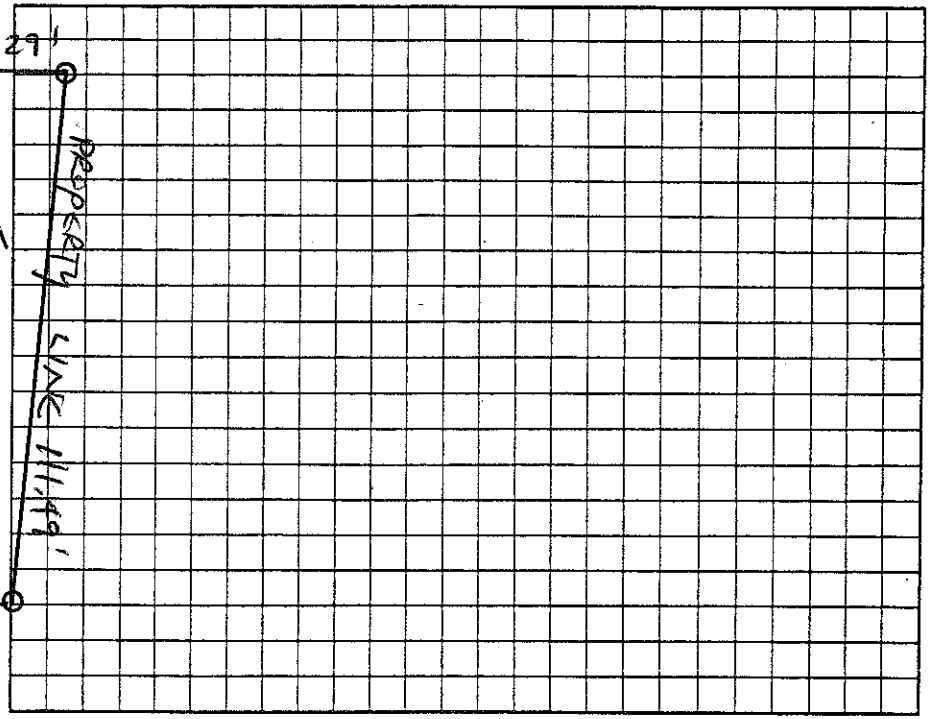

Permit can be suspended or revoked if any false information is supplied toward securing the permit/any unauthorized changes are made to the site/any unauthorized changes are made in the installation of the system. Improvement Permit with plat valid without expiration ☐ Improvement Permit with site plan valid for sixty months ☑ Authorization to Construct is valid for a period equal to that of Improvement Permit – not to exceed sixty months.

Signed: [signature] date 4/24/07 Installed by: Rowan Septic

Improvement Permit by: STEVE HEDRICK date 4-21-07 Operation Permit by: [signature] date 9-13-07

Authorization to Construct by: STEVE HEDRICK date 4-21-07 Existing System Inspection by: date

HEALTH DEPT. COPY: WHITE OWNER COPY (FINAL): YELLOW OWNER COPY (INITIAL): PINK