# IREDELL COUNTY HEALTH DEPARTMENT

2500

STATESVILLE 704-878-5305 (57) MOORESVILLE 704-664-5281

## IMPROVEMENT PERMIT / AUTHORIZATION TO CONSTRUCT / OPERATION PERMIT / EXISTING SYSTEM INSPECTION

PERMIT# TRUITMAN 143088 PIN# 4731-23-4266 DATE 5-19-07

OWNER OR APPLICANT MEDALLION PROPERTIES, INC PHONE: Business 704-634-1185 Home

ADDRESS 185 WHIPPOORWILL ROAD MOORESVILLE NC 28117

LOCATION US 21 SOUTH TR TALLEY ROAD, TL TALLEY RIDGE DRIVE, 1ST LOT ON RIGHT

SUBDIVISION TALLEY RIDGE BLOCK / SECTION ____ LOT 1 LOT AREA 21,784 ft² SITE CLASS. PS DESIGN FLOW 360 L.T.A.R. 0.30 GAD/ft²

Septic Tank: 1000 Gallons; ST# 895-1000 Date 9-16-07

Pump Tank: ____ Gallons; PT ____ Date ____

Pump Make: ____ Model ____ Serial No. ____

Nitrification Field: No Fields 1 Square Feet EQ: 1200 Linear Feet 300

No Lines FOUR Trench Width 36" Max Trench Bottom Depth 36"

☑ New System ☐ Repair ☐ Expansion System Type: I II III IV V VI

System Description: 25% REDUCTION, GRAVITY

Repair System Description: 50% REDUCTION, LOW PRESSURE

Maintenance Agreement Required: ☐ Yes ☑ No

☑ House/Mod. Home ☐ Mobile Home ☐ Business ☐ Other

No. Bedrooms 3 No. Persons ____ No. Employees ____


Water Supply: ☑ Individual ☐ Public ☐ Community WELL

Gravel Depth N/A ☑ Gravity ☐ Pressure ☐ Slab ☐ Crawl Space ☐ Basement w/plumbing ☐ Basement wo/plumbing


Comments/Conditions: GRADE SITE TO UNIFORM SLOPE & CALL HEALTH DEPT. TO FLAG-OUT SYSTEM PRIOR TO INSTALLATION. INSTALL 25% REDUCTION SYSTEM ON CONTOUR.

Comments/Conditions: BLUE - TUFF 1.4

INITIAL SITE SKETCH ~ SCALE: 1"=40'

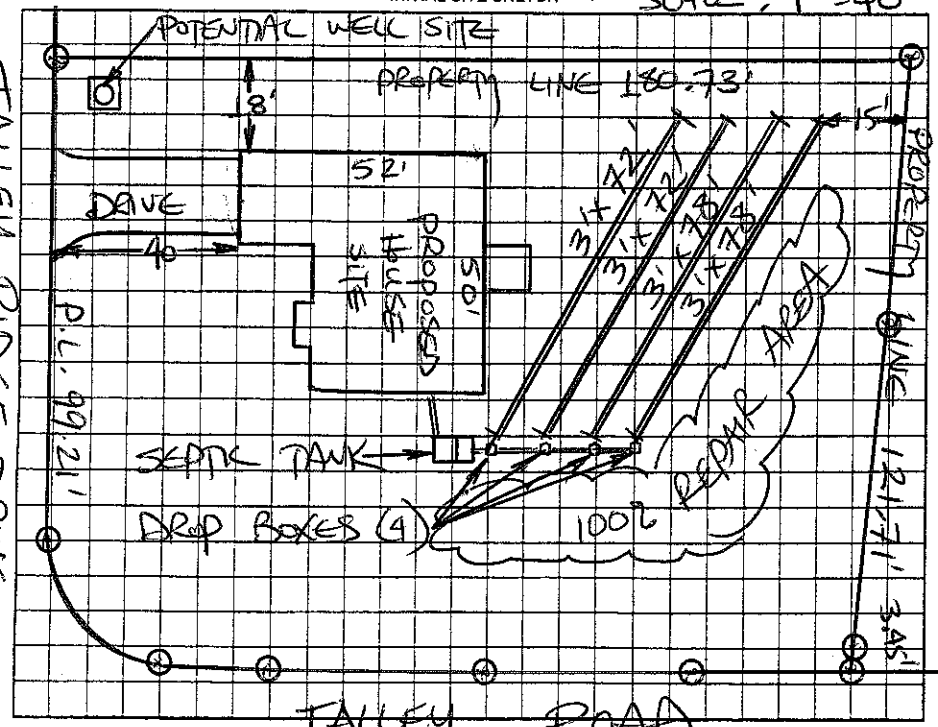


AS BUILT SKETCH

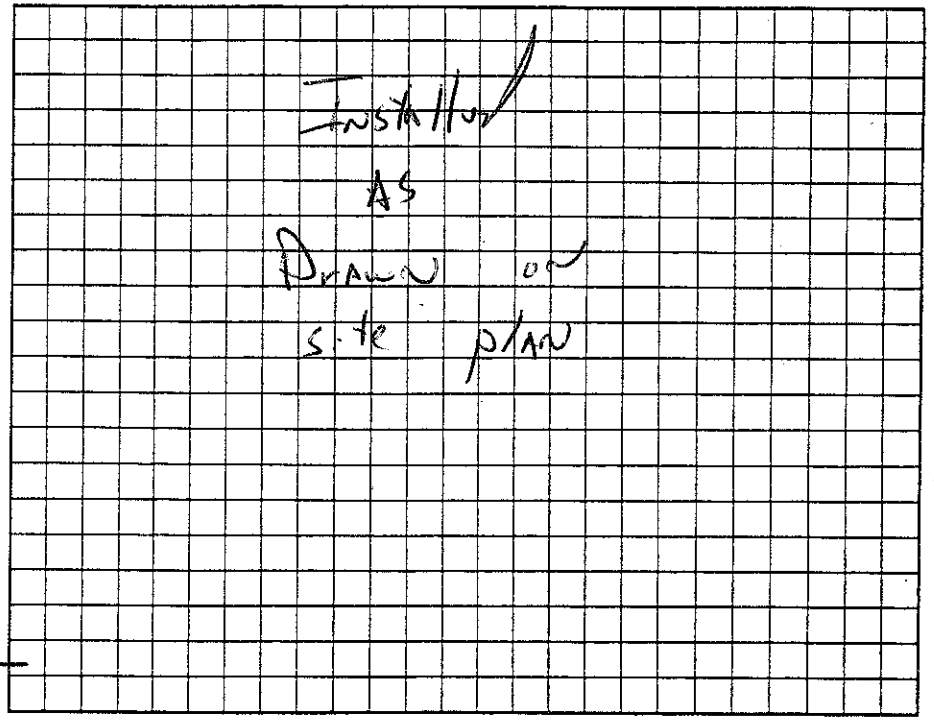


Permit can be suspended or revoked if any false information is supplied toward securing the permit/any unauthorized changes are made to the site/any unauthorized changes are made in the installation of the system. Improvement Permit with plat valid without expiration ☐ Improvement Permit with site plan valid for sixty months ☑ Authorization to Construct is valid for a period equal to that of Improvement Permit – not to exceed sixty months.

Signed: [signature] date 5/22/07 Installed by: Roy Sale

Improvement Permit by: STEVE HENDRICK date 5-19-07 Operation Permit by: [signature], R.S. date 30 Oct. 07

Authorization to Construct by: STEVE HENDRICK date 5-19-07 Existing System Inspection by: ____ date ____

HEALTH DEPT. COPY: WHITE OWNER COPY (FINAL): YELLOW OWNER COPY (INITIAL): PINK