(C1)

IREDELL COUNTY HEALTH DEPARTMENT

STATESVILLE 704-878-5305 MOORESVILLE 704-664-5281

IMPROVEMENT PERMIT / AUTHORIZATION TO CONSTRUCT / OPERATION PERMIT / EXISTING SYSTEM INSPECTION

PERMIT# Transferred 05-03-07 142519 PIN# 4731-23-6097

OWNER OR APPLICANT MEDALLION PROPERTIES, INC PHONE: Business 704-634-1185 Home

ADDRESS 185 WHIPPOORWILL ROAD, MOORESVILLE, NC 28117 DATE 4-21-07

LOCATION US 21 SOUTH, TR TALLEY STREET, TL TALLEY RIDGE DRIVE, 2ND LOT ON LEFT

SUBDIVISION TALLEY RIDGE BLOCK / SECTION LOT 18 LOT AREA 21,815 ft² SITE CLASS PS DESIGN FLOW 360 L.T.A.R. 0.25 GAD/FT²

Septic Tank: 1000 Gallons: STB 825 Date 6-29-07

Pump Tank: 1000 Gallons: PT 302 Date 5-20-07

Pump Make: Zoeller Model AJ-153 Serial No.

Nitrification Field: No Fields 1 Square Feet 1440 Linear Feet 240

No Lines FIVE Trench Width 24" Max Trench Bottom Depth 36" Min Depth 24"

☑ New System ☐ Repair ☐ Expansion System Type: I II III (IV) V VI

System Description: 50% REDUCTION, LOW-PRESS

Repair System Description: 50% REDUCTION, LOW-PRESSURE

Maintenance Agreement Required: ☑ Yes ☐ No

☐ Gravity ☑ Pressure

☐ House/Mod. Home No. Bedrooms 3

☐ Mobile Home No. Persons

☐ Business No. Employees

☐ Other


Water Supply: ☑ Individual ☐ Public ☐ Community WELL

☐ Slab ☑ Crawl Space ☐ Basement w/plumbing ☐ Basement wo/plumbing

Comments/Conditions: ① INSTALL 50% REDUCTION SYSTEM ON CONTOUR AS SHOWN USING 57 PPBPS PANELS on Contour ② SEE ATTACHED SHEETS for PUMP & LOW-PRESSURE REQUIREMENTS ③ A CONTRACT SHALL BE EXECUTED BETWEEN SYSTEM OWNER & A MAINTENANCE ENTITY PRIOR TO ISSUANCE of OPERATION PERMIT

Blue Filter

INITIAL SITE SKETCH

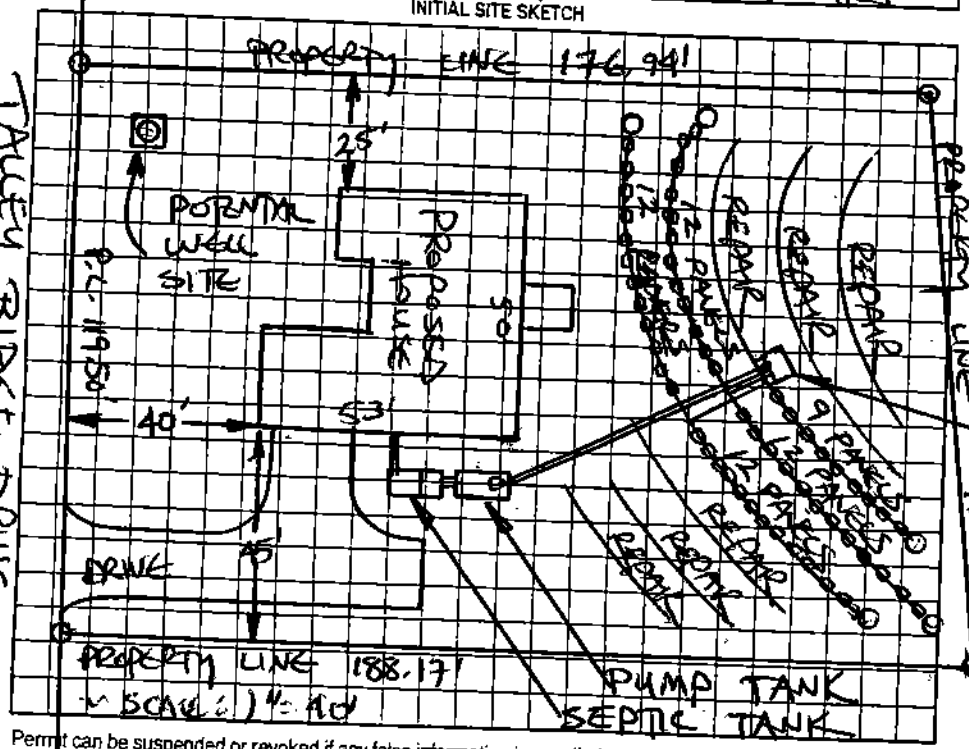

TALLEY RIDGE DRIVE

AS BUILT SKETCH

Permit can be suspended or revoked if any false information is supplied toward securing the permit/any unauthorized changes are made to the site/any unauthorized changes are made in the installation of the system. Improvement Permit with plat valid without expiration ☐ Improvement Permit with site plan valid for sixty months ☑ Authorization to Construct is valid for a period equal to that of Improvement Permit – not to exceed sixty months.

Signed: Neill Campagna date 4/24/07

Improvement Permit by: STEVE HEDRICK date 4-21-07

Authorization to Construct by: STEVE HEDRICK date 4-21-07

Installed by: Rowan Septic

Operation Permit by: R.S. date 23 Aug 07

Existing System Inspection by: date

HEALTH DEPT COPY: WHITE OWNER COPY (FINAL): YELLOW OWNER COPY (INITIAL): PINK