78716

IREDELL COUNTY HEALTH DEPARTMENT

STATESVILLE 704-878-5305 MOORESVILLE 704-664-5281

IMPROVEMENT PERMIT / AUTHORIZATION TO CONSTRUCT / OPERATION PERMIT / EXISTING SYSTEM INSPECTION

PERMIT# TRADITION 08-7-0699 PIN# 4731 29 4945 DATE 12-23-98

OWNER OR CONTRACTOR KENNETH L. PARKER PHONE: Business 363-1212 Home 528-9528

ADDRESS 480 OLD MOUNTAIN ROAD, STATESVILLE, NC 28677

LOCATION O.M.R. TO E. MONBO ROAD, TR PARKWOOD ACRES, TL, PACIFIC DRIVE, 0.2 MILE ON LEFT

SUBDIVISION PARKWOOD ACRES BLOCK / SECTION _____ LOT _____ LOT AREA 3.7 ACRES SITE CLASS PS DESIGN FLOW 360 L.T.A.R. 0.30 GPD/FT2

Septic Tank: 1500 Gallons; STB 190 Date 8/5/99
Pump Tank: _____ Gallons; PT _____ Date _____
Pump Make: _____ Model _____ Serial No. _____
Nitrification Field: No Fields 1 Square Feet 1200 Linear Feet 400
No Lines FOUR Trench Width 36" Max Trench Bottom Depth 36" Gravel Depth 12"

☑ New System ☐ Repair System Type: ☐ I, II, IV, V, VI
System Description: CONVENTIONAL GRAV
Repair System Description: CONV. GRAVITY
Maintenance Agreement Required: ☐ Yes ☑ No
☐ Slab ☐ Crawl Space ☐ Basement w/plumbing ☐ Basement wo/plumbing

☑ House/Mod. Home No. Bedrooms 3
☐ Mobile Home No. Bathrooms 3
☐ Business No. Employees ____
☐ Other W/ SHOP BLDG


Water Supply:
☑ Individual
☐ Public
☐ Community
WELL

Comments:/Conditions: KEEP SYSTEM MINIMUM 100 FEET FROM WELL


Comments:/Conditions:

SCALE: 1" = 40'

INITIAL SITE SKETCH

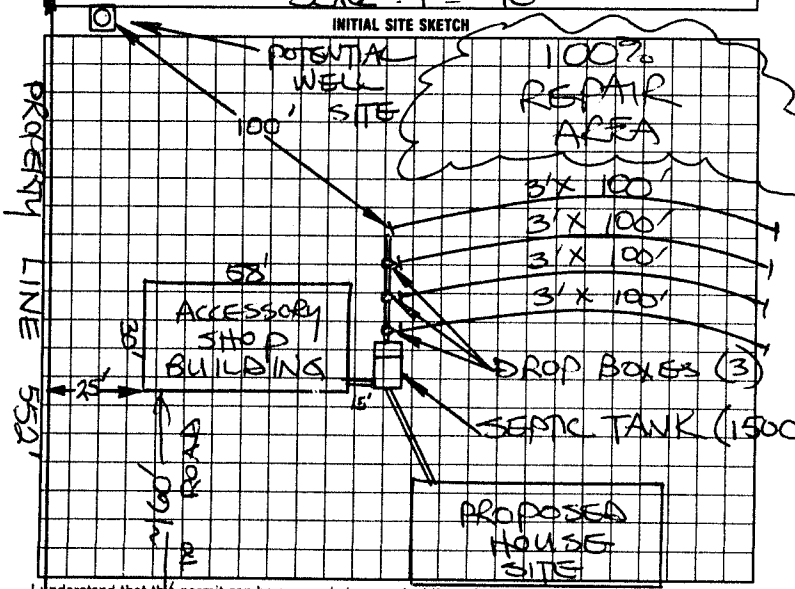

AS BUILT SKETCH

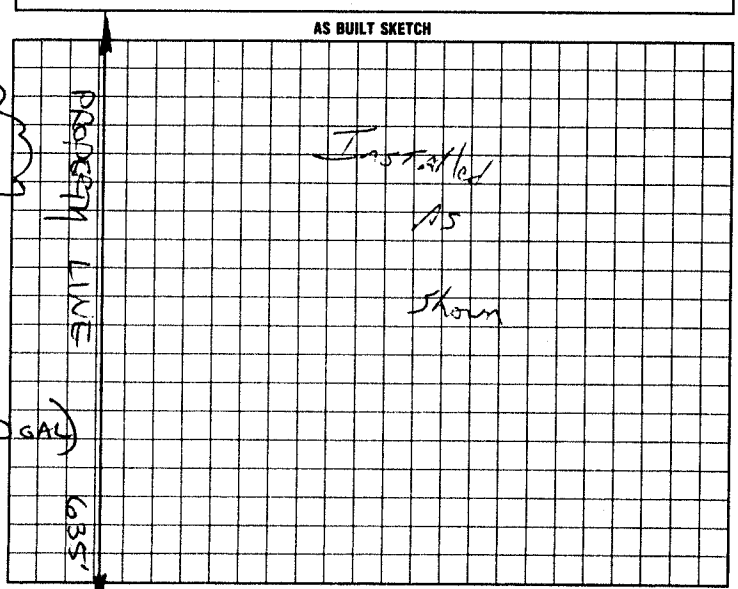

I understand that this permit can be suspended or revoked if any false information is supplied toward securing the permit/any unauthorized changes are made to the site/any unauthorized changes are made in the installation of the system. Improvement Permit with plat valid without expiration. Improvement Permit with site plan valid for sixty months. Authorization to Construct is valid for a period equal to that of Improvement Permit – not to exceed sixty months.

Signed: Kenneth L Parker date 12-23-98 Installed by: Simpson Construction

Improvement Permit by: STEVE HEDRICK date 12-23-98 Operation Permit by: J.C. Potter date OCT 26 99

Authorization to Construct by: STEVE HEDRICK date 12-23-98 Existing System Inspection by: _____ date _____

HEALTH DEPT. COPY: WHITE INSPECTION COPY (FINAL): GREEN OWNER COPY (FINAL): YELLOW INSPECTION COPY (INITIAL): PINK OWNER COPY (INITIAL): GOLD