IREDELL COUNTY HEALTH DEPARTMENT

STATESVILLE 704-878-5305 ✓ MOORESVILLE 704-664-5281

IMPROVEMENT PERMIT / AUTHORIZATION TO CONSTRUCT / OPERATION PERMIT / EXISTING SYSTEM INSPECTION

PERMIT# 104038 PIN# 4731-30-1405 DATE JAN 22, 02

OWNER OR CONTRACTOR DAVID BOHRER PHONE: Business (704) 400-2727 Home (704) 799-6274

ADDRESS 241 WADDELL ROAD, MOORESVILLE, NC 28117

LOCATION US 21S, TR TALLEY STREET, TL LYTTON FARM ROAD, 2ND LOT ON RIGHT PAST CHEROKEE STABLES LN,

SUBDIVISION _____ BLOCK / SECTION _____ LOT _____ LOT AREA 1.7 ACRES SITE CLASS PS DESIGN FLOW 480 L.T.A.R. EXISTING 0.15

Septic Tank: EXISTING Gallons: STB _____ Date _____

Pump Tank: _____ Gallons: PT _____ Date _____

Pump Make: _____ Model _____ Serial No. _____

Nitrification Field: No Fields 1 Square Feet 240 Linear Feet 80

No Lines ONE Trench Width 36" Max Trench Bottom Depth 36" Gravel Depth 12"

✓ New System ☐ Repair System Type: I ☐ II IV V VI

System Description: CONVENTIONAL GRAVITY

Repair System Description: CONVENTIONAL PUMP

Maintenance Agreement Required: ☐ Yes ✓ No

☐ Slab ✓ Crawl Space ☐ Basement w/plumbing ☐ Basement wo/plumbing

☐ House/Mod. Home No. Bedrooms 4

✓ Mobile Home No. Bathrooms 2

☐ Business No. Employees ____


☐ Other _____

Water Supply: ✓ Individual ☐ Public ☐ Community WELL

Comments/Conditions: INSTALL NEW DROP BOX AT LOWER LINE AS SHOWN ② INSTALL NEW 3' X 80' LINE ON CONTOUR AS FLAGGED ON SITE!

Comments/Conditions:

INITIAL SITE SKETCH

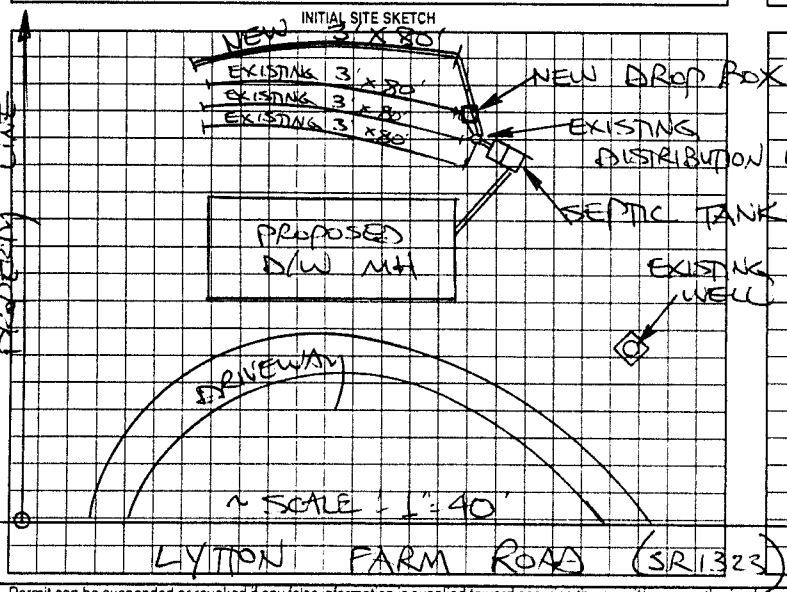

AS BUILT SKETCH

Installed as Shown per Initial Site Sketch

Permit can be suspended or revoked if any false information is supplied toward securing the permit; any unauthorized changes are made to the site; any unauthorized changes are made in the installation of the system. Improvement Permit with plat valid without expiration. Improvement Permit with site plan valid for sixty months. Authorization to Construct is valid for a period equal to that of Improvement Permit – not to exceed sixty months.

Signed: _____ date 1-24-02 Installed by: David Bohrer

Improvement Permit by: STEVE HEDRICK date 1-24-02 Operation Permit by: William O. Johnson date 3/8/02

Authorization to Construct by: STEVE HEDRICK date 1-24-02 Existing System Inspection by: _____ date _____

HEALTH DEPT COPY WHITE OWNER COPY (FINAL) YELLOW OWNER COPY (INITIAL) PINK