IREDELL COUNTY HEALTH DEPARTMENT

STATESVILLE 704-878-5305 MOORESVILLE 704-664-5281

IMPROVEMENT PERMIT / AUTHORIZATION TO CONSTRUCT / OPERATION PERMIT / EXISTING SYSTEM INSPECTION

PERMIT# 05 21099/8927 PIN# 4731309037 DATE Dec 3 99

OWNER OR CONTRACTOR RAY PINION PHONE: Business Home 528 9998

ADDRESS 247 Lytton Farm Rd TROUTMAN

LOCATION NW215 (R) Tally Farm (L) Lytton Farm on Left # 253 Lytton Farm

SUBDIVISION BLOCK / SECTION LOT 5X LOT AREA .57 SITE CLASS PS DESIGN FLOW 360 L.T.A.R. 3

Septic Tank: 1000 Gallons: STB 825 Date 121799
Pump Tank: Gallons: PT Date
Pump Make: Model Serial No.
Nitrification Field: No Fields Square Feet 1200 Linear Feet 300
No Lines 4 Trench Width 36" Max Trench Bottom Depth 31" Gravel Depth N/A

☒ New System ☐ Repair System Type: I, II, (III) IV, V, VI
System Description: 25% Reduction in GRAVITY
Repair System Description: 50% Reduction GRAVITY
Maintenance Agreement Required: ☐ Yes ☒ No


☒ House/Mod. Home No. Bedrooms 3
☐ Mobile Home No. Bathrooms 2
☐ Business No. Employees
☐ Other
☐ Slab ☒ Crawl Space ☐ Basement w/plumbing ☐ Basement wo/plumbing

Water Supply: ☒ Individual ☐ Public ☐ Community WELL


Comments:/Conditions: 5 Chambers or 30 HDS Sections
Keep well 100ft (50ft min if Drilled) or MAX. feasible distance from well

Comments:/Conditions:

INITIAL SITE SKETCH 200ft

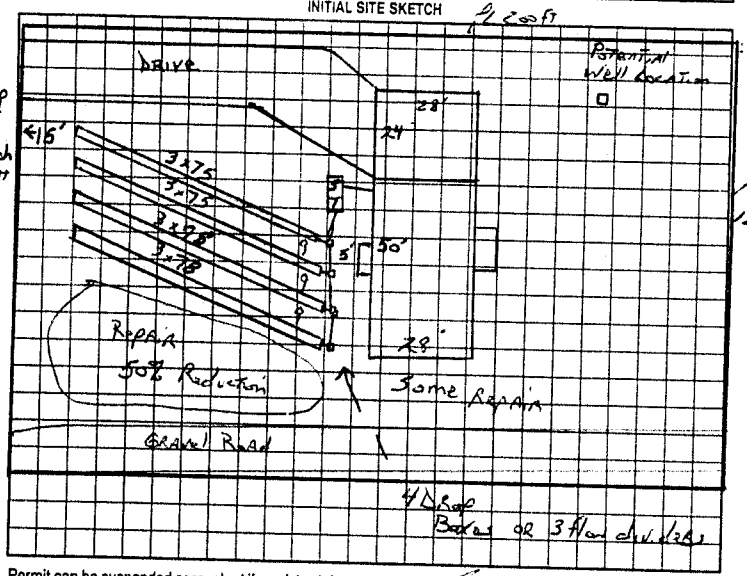

AS BUILT SKETCH

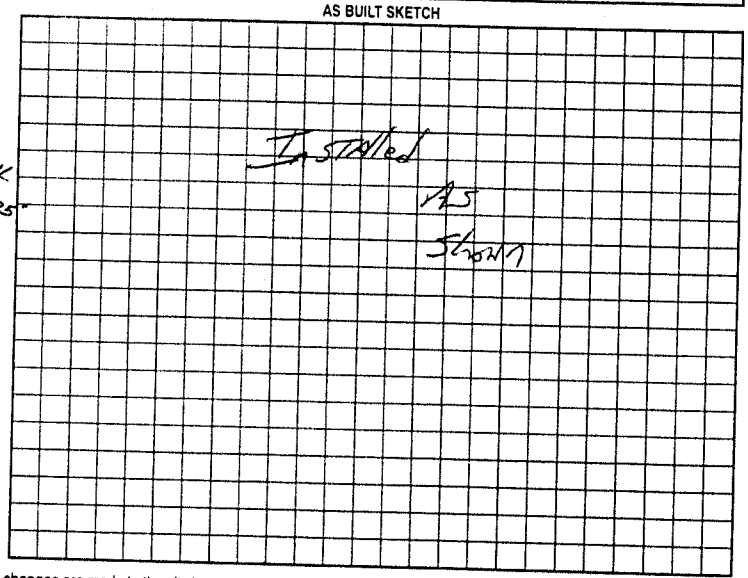

Permit can be suspended or revoked if any false information is supplied toward securing the permit/any unauthorized changes are made to the site/any unauthorized changes are made in the installation of the system. Improvement Permit with plat valid without expiration. Improvement Permit with site plan valid for sixty months. Authorization to Construct is valid for a period equal to that of Improvement Permit – not to exceed sixty months.

Signed: date 12-16-99 Installed by: Royan Septic

Improvement Permit by: J. Potter date Dec 3 99 Operation Permit by: J. Potter date Dec 3 2000

Authorization to Construct by: J. Potter date Dec 3 99 Existing System Inspection by: date

HEALTH DEPT. COPY: WHITE OWNER COPY (FINAL): YELLOW OWNER COPY (INITIAL): PINK