IREDELL COUNTY HEALTH DEPARTMENT

STATESVILLE 704-878-5305 MOORESVILLE 704-664-5281

IMPROVEMENT PERMIT / AUTHORIZATION TO CONSTRUCT / OPERATION PERMIT / EXISTING SYSTEM INSPECTION

PERMIT# 147985 PIN# 4731302775 DATE 8-11-08

OWNER OR APPLICANT Michael B. FOLLIARD PHONE: Business 704-528-7500 / 902-7469 Home 704-528-0735

ADDRESS 224 LYTTON FARM Rd TROUTMAN, NC 28166

LOCATION 21 SOUTH @ TALEY (L) LYTTON FARM CT AT BOX # 224 ON RIGHT PAST Cherokee Stables LANE

SUBDIVISION _____ BLOCK / SECTION _____ LOT _____ LOT AREA 1.42 AC SITE CLASS. PS DESIGN FLOW 480 L.T.A.R. .35

Septic Tank: 1000 Gallons: STB _____ Date _____

Pump Tank: _____ Gallons: PT _____ Date _____

Pump Make: _____ Model _____ Serial No. _____

Nitrification Field: No Fields 1 Square Feet 342 Linear Feet 86'

No Lines 1 X 86' Trench Width 36" Max Trench Bottom Depth 36" Gravel Depth N/A

☒ New System ☐ Repair ☐ Expansion System Type: I II (III) IV V VI

System Description: 6" GRAVITY 25% REDUCTION

Repair System Description: LP 50% REDUCTION

Maintenance Agreement Required: ☐ Yes ☒ No

☒ House/Mod. Home ☐ Mobile Home ☐ Business ☐ Other

No. Bedrooms 4 No. Persons 8 No. Employees _____

Water Supply: ☒ Individual ☐ Public ☐ Community

☒ Gravity ☐ Pressure ☐ Slab ☐ Crawl Space ☒ Basement w/plumbing ☐ Basement wo/plumbing

Comments:/Conditions: (1) This 86' Line Addition Will Bring the total BEDROOM FLOW COUNT TO 4 BEDROOMS (2) MAINTAIN SETBACKS: Supply Line is to be 5' OFF P/L & 10' OFF BASEMENT.

Comments:/Conditions: (3) Read additional comments on permit

INITIAL SITE SKETCH

SEE ATTACHED SYSTEM DESIGN BY LORNE COOK, P.S.

AS BUILT SKETCH

OWNER MARKED P/L'S AS INSTALLED AS (DRAWN)

Permit can be suspended or revoked if any false information is supplied toward securing the permit/any unauthorized changes are made to the site/any unauthorized changes are made in the installation of the system. Improvement Permit with plat valid without expiration ☐ Improvement Permit with site plan valid for sixty months ☒ Authorization to Construct is valid for a period equal to that of Improvement Permit – not to exceed sixty months.

Signed: Michael B. Folliard date 5/12/08

Improvement Permit by: _____ RS date 7-11-08

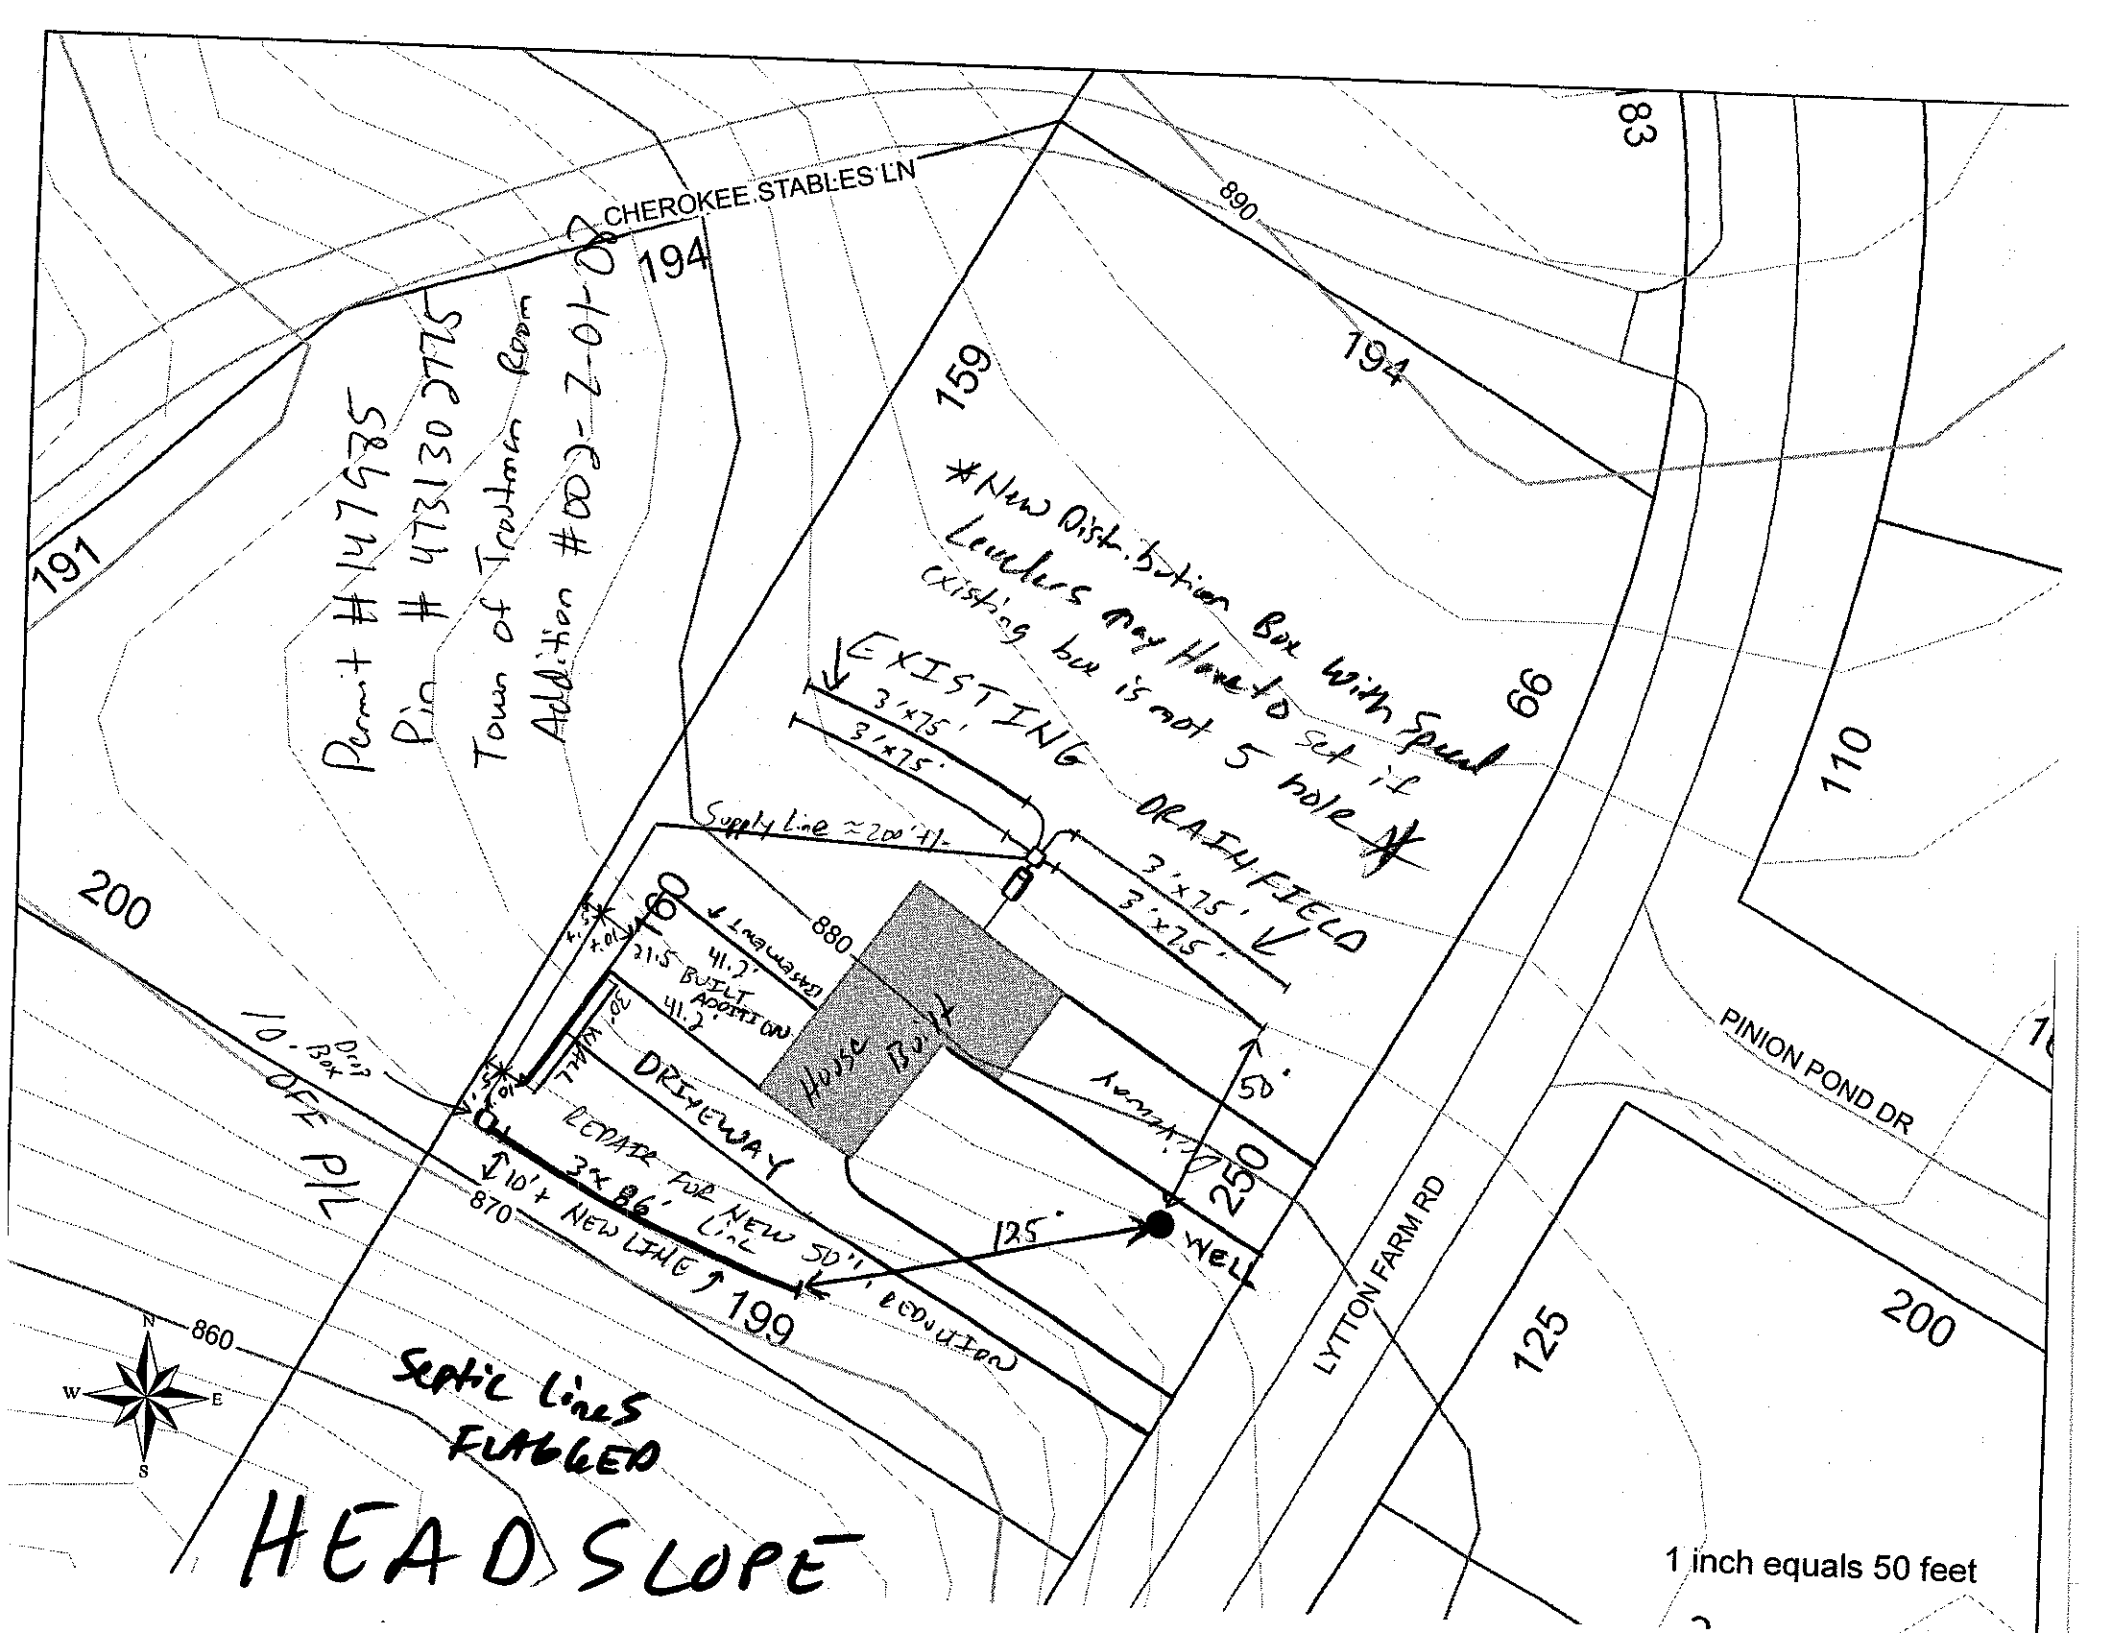
Authorization to Construct by: _____ date 7-11-08

Installed by: Piedmont Backhoe Service

Operation Permit by: _____ date 8-19-08

Existing System Inspection by: _____ date _____

HEALTH DEPT. COPY: WHITE OWNER COPY (FINAL): YELLOW OWNER COPY (INITIAL): PINK


CHEROKEE STABLES LN
194
890
83
159
194
191
66
110
200
Pin # 473130 2775
*New Distribution Box with Spud Leaders may Have to Set it existing box is not 5 hole
EXISTING DRAIN FIELD
3'x75'
3'x75'
3'x75'
3'x75'
Supply Line ≈ 200'+/-
880
House Built
41.2'
21.5' BUILT ADDITION
41.2'
DRIVEWAY
3'x86'
10'+ New Line
870
199
Drip 10-Box
OFF P/L
50'
125'
WELL
250
PINION POND DR
LYTTON FARM RD
125
200
860
N
W
E
S
SEPTIC LINES FLAGGED
HEAD SLOPE
1 inch equals 50 feet